

LAND CORNER RECORDATION CERTIFICATE
Filing Requirement of Act 74, Mich. P.A. 1970

For corners in

<u>Iron</u>	Located In:	Corner Code #	
<small>(County)</small>			
1. Public Land Survey	T ___ R ___	_____	_____
	T ___ R ___	_____	_____
	T ___ R ___	_____	_____
	T ___ R ___	_____	_____
2. Property Controlling in Section	S <u>32</u> T <u>42N</u> R <u>32W</u>	_____	12
	S <u>32</u> T <u>42N</u> R <u>32W</u>	_____	14
3. Miscellaneous Property in Sec.	S ___ T ___ R ___	_____	_____
	S ___ T ___ R ___	_____	_____

Register of Deeds Stamp & File Number

4. Lot No. _____, Recorded Plat _____
 5. Private Claims _____

14 May 07 2003
 12 Apr 23 2003

I, Stephan J. Szyszkoski, in a field survey on _____, 20___ do hereby state that under requirements of P.A. 74, Michigan P.A. of 1970, the corner points mentioned in lines 1 and 2 above were in conformance with regulations and rules therefore as required in the current manual of survey instructions of the United States Department of the Interior, Bureau of Land Management or by a decree of a Court of Law and /or that the corner points mentioned in lines 3, 4 and 5 above were in conformance with the rules of the Michigan Board of Land Surveyors or by a Decree of a Court of Law; established, re-established, monumented, recovered, found as expressed below:

NOTE: Not more than 2 corners, all in the same town and range, may be recorded on this certificate.


A	B	C	D	E	F	G	H	I	J	K	L	M
1												
2	6	5	4	3	2	1						
3												
4	7	8	9	10	11	12						
5												
6	18	17	16	15	14	13						
7												
8	19	20	21	22	23	24						
9												
10	30	29	28	27	26	25						
11												
12	31	32	33	34	35	36						
13												

A. Description of original monument and accessories and/or subsequent restoration:
 (12-Sec. 32) South 1/16 corner, Section 32. Not established in the original survey.
 (14-Sec. 32) South 1/16 corner between Sections 32 & 33. Established in 1971 by A.O.Enger midway and on line between Quarter and Section corners 1316.4' north and south.

B. Description of corner evidence found and/or method applied in restoring or reestablishing corner:
 (12-Sec. 32) Established the corner midway and on a straight line between Quarter corner 1323.49' south and Center of Section 1323.49' north.
 (14-Sec. 32) Recovered the 1971 monument, disturbed and damaged. Remonumented the corner midway and on a straight line between Quarter and Section corners 1315.50' north and south. The remaining BT Cedar SE marked by Enger is in place and checks with the record.

C. Description of monument for corner and accessories established to perpetuate locating the position of the corner:

(12) Set 1"IDx32" I.pipe with 4" alum. MDNR cap. Blazed, scribed, and set measuring nails in: 20" W.Pine N02E 22.5' "1/16S BT" 11" W.Spruce N83E 37.5' do 5" W.Spruce S64E 29.5' do 8" Cedar S31W 26.6' do Set sq'd cedar post adjacent. Bearings are magnetic. Distances are to nail with tag.	(14) Set 1"IDx32" I.pipe with 4" alum. MDNR cap. Blazed, scribed, and set measuring nails in: 7" Cedar S78E 17.75' "1/16S BT" 5" Cedar S23E 22.0' do 5" Maple S44W 2.55' do 7" Cedar S13E 32.5' 1971 BT w/scribing visible. Placed a sq'd cedar post adjacent. Bearings are magnetic. Distances are to nail with tag.
--	---

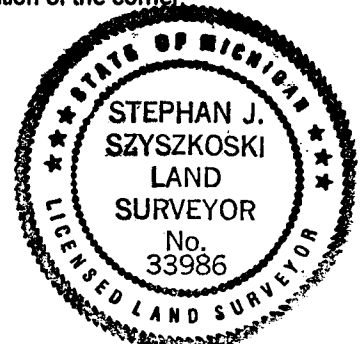

Signed by Stephan J. Szyszkoski
 Surveyor's Michigan License No. 33986

Date 6/2/03