

LAND CORNER RECORDATION CERTIFICATE
Filing Requirement of Act 74, Mich. P.A. 1970

For corners in

Iron

(County)

Located In:

Corner Code #

1. Public Land Survey

T ___ R ___
 T ___ R ___
 T ___ R ___
 T ___ R ___

2. Property Controlling
 in Section

S 29 T 42N R 32W 6
 S 29 T 42N R 32W 9

3. Miscellaneous
 Property in Sec.

S ___ T ___ R ___
 S ___ T ___ R ___

Register of Deeds Stamp & File Number

4. Lot No. _____, Recorded Plat _____

5. Private Claims _____

Jul 22 2003

I, Stephan J. Szyszkoski, in a field survey on _____, 20__ do hereby state that under requirements of P.A. 74, Michigan P.A. of 1970, the corner points mentioned in lines 1 and 2 above were in conformance with regulations and rules therefore as required in the current manual of survey instructions of the United States Department of the Interior, Bureau of Land Management or by a decree of a Court of Law and /or that the corner points mentioned in lines 3, 4 and 5 above were in conformance with the rules of the Michigan Board of Land Surveyors or by a Decree of a Court of Law; established, re-established, monumented, recovered, found as expressed below:

NOTE: Not more than 2 corners, all in the same town and range, may be recorded on this certificate.

1	A	B	C	D	E	F	G	H	I	J	K	L	M
2		6		5		4		3		2		1	
3													
4		7		8		9		10		11		12	
5													
6		18		17		16		15		14		13	
7													
8		19		20		21		22		23		24	
9													
10		30		29		28		27		26		25	
11													
12		31		32		33		34		35		36	
13													

A. Description of original monument and accessories and/or subsequent restoration:
 (6-Sec. 29) Northeast 1/16 corner, Sec. 29. Not established in the original survey.
 (9-Sec. 29) East 1/16 corner, Section 29. Not established in the original survey.


B. Description of corner evidence found and/or method applied in restoring or reestablishing corner:

(6-Sec. 29) Established the corner at the intersection of straight lines connecting opposite 1/16 corners.
 (9-Sec. 29) Established the corner midway and on a straight line between Center of Section 1320.65' West and Quarter corner 1320.65' East.

C. Description of monument for corner and accessories established to perpetuate locating the position of the corner:

(6) Set 1"IDx32" I.pipe with 4" alum. MDNR cap. Blazed, scribed, and set measuring nails in:
 5" W.Pine N08E 67.9' "1/16S BT"
 7" Poplar S38W 3.8' do
 8" W.Spruce N66W 55.5' do
 5" Poplar N4W 9.6' do
 Set sq'd cedar post adjacent. Bearings are magnetic. Distances are to nail with tag.

(9) Set 1"IDx32" I.pipe with 4" alum. MDNR cap. Blazed, scribed, and set measuring nails in:
 4" R.Pine N86E 49.3' "1/16S BT"
 7" R.Pine S46E 70.1' do
 5" W.Pine S09W 43.1' do
 7" J.Pine N81W 34.9' do
 Set sq'd cedar post adjacent. Bearings are magnetic. Distances are to nail with tag.

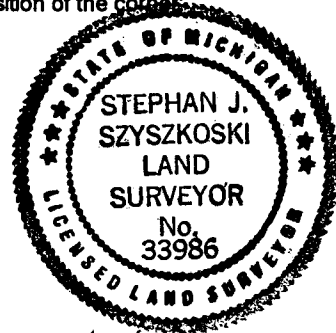

Signed by Stephan J. Szyszkoski
 Surveyor's Michigan License No. 33986

Date 8/6/03