

LAND CORNER RECORDATION CERTIFICATE
Filing Requirement of Act 74, Mich. P.A. 1970 as Amended

For corners in

<u>Iron</u> (County)	Located In:	Corner Code #
1. Public Land Survey	T <u>42N</u> R <u>32W</u>	<u>H3</u>
	T _____ R _____	_____
	T _____ R _____	_____
	S _____ T _____ R _____	_____
2. Property Controlling in Section	S <u>10</u> T <u>42N</u> R <u>32W</u>	<u>6</u>
	S _____ T _____ R _____	_____
3. Miscellaneous Property in Sec.	S _____ T _____ R _____	_____
	S _____ T _____ R _____	_____

Register of Deeds Stamp & File Number

4. Lot No. _____, Recorded Plat _____
 5. Private Claims

H3 May 30 2006
 6 Mar 25 2006

1	A	B	C	D	E	F	G	H	I	J	K	L	M
2	6	5	4	3	2	1							
3								●					
4	7	8	9	10	11	12							
5													
6	18	17	16	15	14	13							
7													
8	19	20	21	22	23	24							
9													
10	30	29	28	27	26	25							
11													
12	31	32	33	34	35	36							
13													

I, Stephan J. Szyszkoski, in a field survey on _____, 20____ do hereby state that under requirements of P.A. 74, Michigan P.A. of 1970, the corner points mentioned in lines 1 and 2 above were in conformance with regulations and rules therefore as required in the current manual of survey instructions of the United States Department of the Interior, Bureau of Land Management or by a decree of a Court of Law and /or that the corner points mentioned in lines 3, 4 and 5 above were in conformance with the rules of the Michigan Board of Land Surveyors or by a Decree of a Court of Law; established, re-established, monumented, recovered, found as expressed below:

NOTE: Not more than 2 corners, all in the same town and range, may be recorded on this certificate.

A. Description of original monument and accessories and/or subsequent restoration:


(H3) Quarter corner common to Sections 3 and 10. 1849 - Established by Zelotes B. Searles, Deputy Surveyor: West corrected between Sections 3 and 10 ... 39.89 Set W.Pine qr. Section post. Spruce Pine 12 S71E 33 links, Spruce Pine 10 North 7 links. ...79.78 Section corner. Found no subsequent record.
 (6-Sec. 10) Northeast 1/16 corner, Section 10. Not established in the original survey.

B. Description of corner evidence found and/or method applied in restoring or reestablishing corner:

(H3) The original post and accessories were not recovered. Found, but did not accept, a WI-MI Power Company monument with brass cap N32E 16.7' from the position subsequently monumented. Reestablished the corner midway and on the section line between Section corners 2633.14' east and west. It appears that the WMPCO monument was intended to be placed at this midway position but, due to some error, was placed at the erroneous position found: The East 1/16 between 3 and 10, also a WMPCO monument, falls very nearly midway between corner I3 and corner H3, herein described.
 (6-Sec. 10) Established the corner at the intersection of straight lines connecting opposite 1/6 corners.

C. Description of monument for corner and accessories established to perpetuate locating the position of the corner:

(H3) Set 1"IDx32" I.pipe with 4" alum. MDNR cap. Set measuring nails in: 12" R.Pine N68W 78.5' mrkd "1/4S NBT" 12" R.Pine N42W 47.3' do 16" R.Pine N08E 76.3' do 9" J.Pine N37E 14.9' do Fd. WMPCO mon N32E 16.7' distant. Bearings are magnetic. Distances to trees are to nail with tag. Set sq'd R.Pine post adjacent.	(6) Set 1"IDx32" I.pipe with 4" alum. MDNR cap. Set measuring nails in: 6" J.Pine N27E 49.7' mrkd "1/16S BT" 9" J.Pine N70E 34.4' do 8" J.Pine S72W 84.9' do 10" J.Pine N52W 73.5' do Set sq'd cedar post adjacent. Bearings are magnetic. Distances are to nail with tag.
--	--

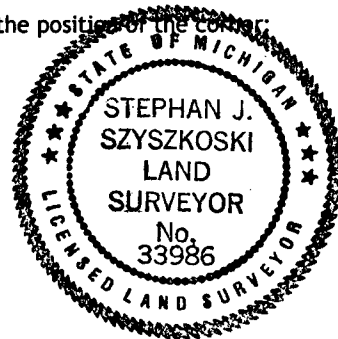

Signed by Stephan J. Szyszkoski
 Surveyor's Michigan License No. 33986

Date 7/27/06