LAND CORNER RECORDATION CERTIFICATE
Filing Requirement of Act 74, Mich. P.A. 1970 as Amended

For corners in

Iron (County)

		Located In:		Corner Code #
1. Public Land Survey		T 42N	R 32W	I3
		T____	R____	
		T____	R____	
	S____	T____	R____	
2. Property Controlling	S 11	T 42N	R 32W	4
in Section	S____	T____	R____	
3. Miscellaneous	S____	T____	R____	
Property in Sec.	S____	T____	R____	

Register of Deeds Stamp & File Number

4. Lot No. _____ , Recorded Plat_____
5. Private Claims

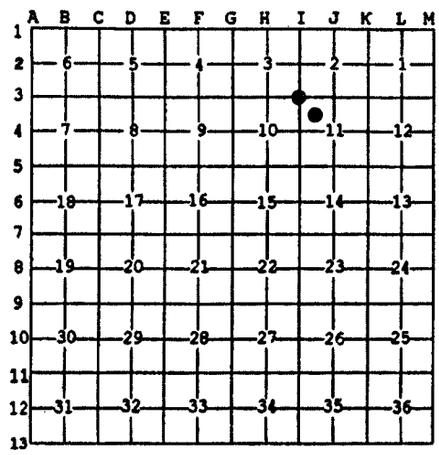

Mar 16 2006

I, Stephan J. Szyszkoski, in a field survey on _____, 20 ____ do hereby state that under requirements of P.A. 74, Michigan P.A. of 1970, the corner points mentioned in lines 1 and 2 above were in conformance with regulations and rules therefore as required in the current manual of survey instructions of the United States Department of the Interior, Bureau of Land Management or by a decree of a Court of Law and /or that the corner points mentioned in lines 3, 4 and 5 above were in conformance with the rules of the Michigan Board of Land Surveyors or by a Decree of a Court of Law; established, re-established, monumented, recovered, found as expressed below:

NOTE: Not more than 2 corners, all in the same town and range, may be recorded on this certificate.

A. Description of original monument and accessories and/or subsequent restoration:

(I3) Corner common to Sections 2-3-10-11. 2001: Recorded by G.L.Pisoni RLS - Found WI/MI Power Company monument with brass cap. Bearing tree found: J.Pine 15" N19W 24.87'. New witnesses: Popple 16" N83W 67.81', Popple 5" N70E 43.08', Popple 5" S27E 92.38', Steel sign post N55W 1.0'. Corner record was approved by Iron County Peer Review Group and is recorded in L.9 of L.C.R., Page 170.
(4-Sec. 11) Northwest 1/16 corner, Section 11. Not established in the original survey. Established in 2001 by Gary L. Pisoni, RLS and shown on survey recorded in L. 1 of surveys, Page 438, Iron County Records. The survey notes a 5/8"x30" rebar set at the corner and a found brass capped iron pipe (W.M.P.CO.) monument S52 deg. 02'24"W, 3.92' distant.

B. Description of corner evidence found and/or method applied in restoring or reestablishing corner:

(I3) Found the WI-MI Power Company monument of record, in good condition, and at record bearing and distance from the 2001 witnesses, all in good condition. The Jack Pine "Bearing tree found" in the 2001 record is now dead. Added 1 new witness tree as described below.
(4-Sec. 11) Found and accepted a 5/8" rebar, in good condition, and at record bearing and distance from a 2"dia. I.Pipe WI-MI Power Company monument with brass cap. Accepted the 5/8" rebar as a careful and faithful establishment of the position of the corner and drove a 1"X32" I.pipe with 4" alum. MDNR cap over the top of it.

C. Description of monument for corner and accessories established to perpetuate locating the position of the corner:

(I3) Found WI-MI Power Co. concrete monument with brass tablet. Set measuring nail in the following NBT:
8" Popple N09W 46.1' mrkd "S3 NBT"
Bearing is magnetic. Distance is to nail with tag. The 2001 witness trees described in the previous record are in good condition.

(4) Set 1"IDx32" I.pipe with 4" alum. MDNR cap over top of found 5/8" rebar.
Set measuring nails in:
11" J.Pine S10E 109.7' mrkd "1/16S BT"
15" J.Pine S12W 123.5' do
7" Poplar S54W 19.4' do
Bearings are magnetic. Distances are to nail with tag.

STATE OF MICHIGAN
STEPHAN J. SZYSZKOSKI
LAND SURVEYOR
No. 33986
LICENSED LAND SURVEYOR

Signed by Stephan J. Szyszkoski Date 7/26/06

Surveyor's Michigan License No. 33986

For the Michigan Department of Natural Resources, Office of Land and Facilities

FORM APPROVED BY MICHIGAN STATE BOARD OF PROFESSIONAL SURVEYORS, JAN. 28, 1971
Revised May 14, 1975
Revised Jan., 1983
Rervised Oct., 1995