

LAND CORNER RECORDATION CERTIFICATE
Filing Requirement of Act 74, Mich. P.A. 1970 as Amended

For corners in

<u>Iron</u> <small>(County)</small>	Located In:	Corner Code #	
1. Public Land Survey	T _____ R _____	_____	
	T _____ R _____	_____	
	T _____ R _____	_____	
2. Property Controlling in Section	S _____ T _____ R _____	_____	
	S <u>26</u> T <u>42N</u> R <u>32W</u>	<u>3</u>	
	S <u>26</u> T <u>42N</u> R <u>32W</u>	<u>10</u>	
3. Miscellaneous Property in Sec.	S _____ T _____ R _____	_____	
	S _____ T _____ R _____	_____	

Register of Deeds Stamp & File
Number

4. Lot No. _____, Recorded Plat _____
 5. Private Claims

10 Mar 27 2007
 3 Mar 22 2007

I, Stephan J. Szyszkoski, in a field survey on _____, 20____ do hereby state that under requirements of P.A. 74, Michigan P.A. of 1970, the corner points mentioned in lines 1 and 2 above were in conformance with regulations and rules therefore as required in the current manual of survey instructions of the United States Department of the Interior, Bureau of Land Management or by a decree of a Court of Law and /or that the corner points mentioned in lines 3, 4 and 5 above were in conformance with the rules of the Michigan Board of Land Surveyors or by a Decree of a Court of Law; established, re-established, monumented, recovered, found as expressed below:

NOTE: Not more than 2 corners, all in the same town and range, may be recorded on this certificate.

A. Description of original monument and accessories and/or subsequent restoration:


(3-Sec. 26) North 1/16 corner between Sections 26 and 27. 1971 - Established by A.O.Enger on line between section corner 1323.37' north and quarter corner 1323.37' south. Set 1"IDx36" I.pipe with 4" aluminum cap. J. Pine 3" N13W 58.2', J. Pine 3" S11E 83.9'.
 (10-Sec. 26) South 1/16 corner between Sections 26 and 27. 1971 - Established by A.O.Enger RLS on line between 1/4 corner 1323.37' north and section corner 1323.37' south. Set 1"IDx36" I.pipe with 4" aluminum cap. Cedar 5" S58W 33.0', W.Spruce 12" N30W 24.8'.

B. Description of corner evidence found and/or method applied in restoring or reestablishing corner:

(3-Sec. 26) Found the 1971 monument, in good condition, and at the record position. The 1971 witnesses were not recovered. Left the monument in place and made new witnesses as described below.
 (10-Sec. 26) Found the 1971 monument in good condition and at record bearing and distance from the 1971 witnesses. The Cedar is a dead stub. The W.Spruce is in good condition. Verified the position of the monument with respect to the adjacent 1/4 and section corners of record and accepted it as a careful and faithful establishment of the position of the corner.

C. Description of monument for corner and accessories established to perpetuate locating the position of the corner:

(3) Found 1"ID I.pipe with 4" alum. MDNR cap. Set measuring nails in: 4" J.Pine N40E 15.3' mrkd "1/16S BT" 3" J.Pine S61E 26.8' do 4" J.Pine S46W 28.8' do 4" J.Pine N21W 7.1' do Set sq'd J.Pine post adjacent. Bearings are magnetic. Distances are to nail with MDNR tag.	(10) Found 1"ID I.pipe with 4" alum. MDNR cap. Set measuring nails in: 4" Balsam N19E 18.7' mrkd "1/16S BT" 5" Spruce S58E 16.6' do 5" Spruce S15E 22.0' do 12" W.Spruce N26W 24.7' old blazes * Bearings are magnetic. Distances are to nail with MDNR tag. * denotes 1971 BT.
---	--

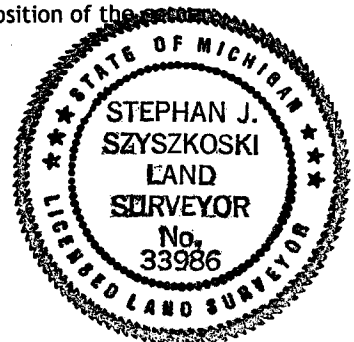

Signed by Stephan J. Szyszkoski
 Surveyor's Michigan License No. 33986

Date 4/19/07

For the Michigan Department of Natural Resources, Office of Land and Facilities