

**LAND CORNER RECORDATION CERTIFICATE**  
**Filing Requirement of Act 74, Mich. P.A. 1970 as Amended**

For corners in

Iron	Located In:	Corner Code #
<small>(County)</small>		
1. Public Land Survey	T ___ R ___	_____
	T ___ R ___	_____
	T ___ R ___	_____
	S ___ T ___ R ___	_____
2. Property Controlling in Section	S <u>26</u> T <u>42N</u> R <u>32W</u>	<u>15</u>
	S <u>26</u> T <u>42N</u> R <u>32W</u>	<u>C-N-NW 1/64</u>
3. Miscellaneous Property in Sec.	S ___ T ___ R ___	_____
	S ___ T ___ R ___	_____

Register of Deeds Stamp & File Number

4. Lot No. \_\_\_\_\_, Recorded Plat \_\_\_\_\_

5. Private Claims

15 Mar 27 2007  
 C-W Mar 22 2007

I, Stephan J. Szyszkoski, in a field survey on \_\_\_\_\_, 20\_\_ do hereby state that under requirements of P.A. 74, Michigan P.A. of 1970, the corner points mentioned in lines 1 and 2 above were in conformance with regulations and rules therefore as required in the current manual of survey instructions of the United States Department of the Interior, Bureau of Land Management or by a decree of a Court of Law and /or that the corner points mentioned in lines 3, 4 and 5 above were in conformance with the rules of the Michigan Board of Land Surveyors or by a Decree of a Court of Law; established, re-established, monumented, recovered, found as expressed below:

**NOTE: Not more than 2 corners, all in the same town and range, may be recorded on this certificate.**

**A. Description of original monument and accessories and/or subsequent restoration:**

(C-N-NW 1/64) The SW corner of the NW1/4 of the NE1/4 of the NW1/4 of Section 26. Not established in the original survey.  
 (15-Sec. 26) West 1/16 corner between Sections 26 and 35. 1971 - Established by A.O.Enger RLS midway and on line between Section corner 1323.04' west and 1/4 corner 1323.04' east. Set 1" ID I.pipe with 4" alum. cap. W.Pine 24" S45W 75.0', R.Pine 8" N63W 51.2'.


**B. Description of corner evidence found and/or method applied in restoring or reestablishing corner:**

(C-N-NW 1/64) Established the corner midway and on a straight line between 1/16 corner #1 and 1/16 corner #4, Section 26.  
 (15-Sec. 26) The 1971 monument was recovered disturbed. Remonumented the corner midway and on the Section line between Section corner 1321.51' west and 1/4 corner 1321.51' east. From the position remonumented, the remaining 1971 BT checks, as described below.

**C. Description of monument for corner and accessories established to perpetuate locating the position of the corner:**

(C-N-NW 1/64) Set 1" IDx32" I.pipe with 4" alum. MDNR cap. Set measuring nails in:	(15) Set 1" IDx32" I.pipe with 4" alum. MDNR cap. Set measuring nails in:
2" Cherry N32E 25.8' mrkd "1/64S BT"	3" R.Pine N43E 12.1' mrkd "1/16S BT"
3" J.Pine S19E 42.3' do	8" twin R.Pine S19E 53.7' do
4" W.Spruce S22W 69.3' do	3" R.Pine N40W 5.8' do
3" J.Pine N71W 34.1' do	32" W.Pine S49W 75.3' old blazes *
Bearings are magnetic. Distances are to nail with MDNR tag.	Bearings are magnetic. Distances are to nail with MDNR tag. * denotes 1971 BT.

1	A	B	C	D	E	F	G	H	I	J	K	L	M
2	6		5		4		3		2		1		
3													
4	7		8		9		10		11		12		
5													
6	18		17		16		15		14		13		
7													
8	19		20		21		22		23		24		
9													
10	30		29		28		27		26		25		
11													
12	31		32		33		34		35		36		
13													

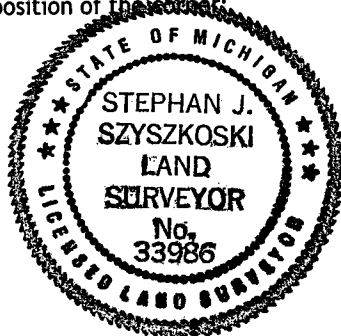

Signed by Stephan J. Szyszkoski  
 Surveyor's Michigan License No. 33986

Date 4/19/07

For the Michigan Department of Natural Resources, Office of Land and Facilities