

LAND CORNER RECORDATION CERTIFICATE
Filing Requirement of Act 74, Mich. P.A. 1970

For corners in
Iron


(County)	Located In:	Corner Code -#
1. Public Land Survey	T 42N R 32W	H11
	T 42N R 32W	H12
	T 42N R 32W	H12
2. Property Controlling in Section	S T R	
	S T R	
3. Miscellaneous Property in Sec.	S T R	
	S T R	

Register of Deeds Stamp & File Number

4. Lot No. _____, Recorded Plat _____
5. Private Claims _____

I, Stephan J. Szyszkoski, in a field survey on February 24, 1994, 19_____, do hereby certify that under requirements of P.A. 74, Michigan P.A. of 1970, the corner points mentioned in lines 1 and 2 above were in conformance with regulations and rules therefore as required in the current manual of survey instructions of the United States Department of the Interior, Bureau of Land Management or by a decree of a Court of Law and/or that the corner points mentioned in lines 3, 4 and 5 above were in conformance with the rules of the Michigan Board of Land Surveyors or by a Decree of a Court of Law, established, re-established, monumented, re-monumented, recovered, found as expressed below:

NOTE: Not more than 4 corners, all in the same town and range, may be recorded on this certificate.

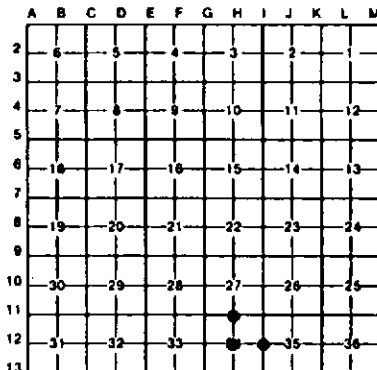

A. Description of original monument and accessories and/or subsequent restoration:

(H11) Quarter corner common to Sections 27-34. Corner previously reestablished and recorded in 1971 by Arthur O. Enger, RLS by single proportionate measurement to the original record between section corners East and West. Corner position perpetuated as follows: Set 1" I.D. x36" iron pipe with 4" aluminum cap and NBTs - 7" Aspen S70W 9.0', 7" Aspen N17E 8.0', 16" R. Pine S37E 41.0'. Found no subsequent record.

(H12) Quarter corner common to Sections 34-35. Corner previously reestablished in 1971 by Arthur O. Enger, RLS by single proportionate measurement to the original record between section corners 1/2 mile north and south. Placed a 1" I.D. x36" iron pipe with 4" aluminum cap at the corner and marked the following NBTs: 5" Tamarack N28E 7.4', 4" Tamarack S46E 11.4', 4" Tamarack S50W 12.2'. Found no subsequent record.

(H12) Center of Section 34. Corner not established in the original survey. Found no subsequent record.

B. Description of corner evidence found and/or method applied in restoring or reestablishing corner:

(H11) Found and accepted the 1971 monument as described above, in good condition, at record bearing and distance from the 1971 NBTs. The Aspen NBTs are both dead, the R. Pine in good condition. Marked three new witnesses as described below.

(H12) Found and accepted the monument as described above, in good condition, at record bearing and distance from the 1971 bearing trees. The tamaracks in the NE and SW quadrants are in good condition. That in the SE quadrant is dead and hollow, but standing. No marks were visible on this tree. Marked two new witnesses as described below.

(H12) Found no evidence of prior monumentation. Established the corner at the intersection of straight lines connecting opposite quarter corners, all monumented. At the position for the corner, I placed a 1" I.D. x36" iron pipe capped with a yellow plastic cap stamped "MICH DNR LS 33986".

C. Description of monument for corner and accessories established to perpetuate locating the position of the corner:

(H11) Found 1" pipe with 4" MDNR cap. Blazed and scribed the following new bearing trees:
12' W. Pine N73E 45.3' 1/4S NBT
5' W. Pine N74W 41.4' 1/4S NBT
8' W. Pine S47W 20.6' 1/4S NBT
Bearings are magnetic.

(H12) Found 1" pipe with 4" MDNR cap. Blazed and scribed the following new bearing trees:
7' Tamarack S34E 10.7' 1/4S NBT
7' Tamarack N34W 14.9' 1/4S NBT
Bearings are magnetic.

(H12) Set a 1" x36" iron pipe with cap. Blazed and scribed the following bearing trees:
4' R. Pine N25W 6.0' 1/4S BT
7' Maple S89W 21.2' 1/4S BT
3' W. Pine S46E 15.3' 1/4S BT
4' W. Pine N81E 9.2' 1/4S BT
Placed a location poster on a 7" squared aspen S83E 1 ft. from the corner. Bearings are magnetic.

Signed by Stephan J. Szyszkoski
Surveyor's Michigan License No. 33986



Date 3-7-94