

MAR 09 2000

SECTION

LAND CORNER RECORDATION CERTIFICATE
Filing Requirement of Act 74, Mich. P.A. 1970

For corners in

Iron (County)	Located in:	Corner Code #
1. Public Land Survey	T <u>42N</u> R <u>33W</u>	<u>A-12</u> ✓
	T <u>42N</u> R <u>34W</u>	<u>M-12</u>
	T _____ R _____	_____
	T _____ R _____	_____
2. Property Controlling In Section	S _____ T _____ R _____	_____
	S _____ T _____ R _____	_____
3. Miscellaneous Property in Sec.	S _____ T _____ R _____	_____
	S _____ T _____ R _____	_____

IRON COUNTY
MICHIGAN
RECEIVED FOR RECORD

99 DEC 30 AM 10: 31

L.C. Records; L. 8, P. 119

Gary L. Pisoni
COUNTY REPRESENTATIVE

Register of Deeds Stamp & File Number

4. Lot No. _____, Recorded Plat _____
5. Private Claims _____

Quarter Corner between S. 36, T42N R34W and S. 31, T42N R33W

I, Gary L. Pisoni, in a field survey on December 4, 1996 do hereby state that under requirements of P.A. 74, Michigan P.A. of 1970, the corner points mentioned in lines 1 and 2 above were in conformance with regulations and rules therefore as required in the current manual of survey instructions of the United States Department of the Interior, Bureau of Land Management or by a decree of a Court of Law and /or that the corner points mentioned in lines 3, 4 and 5 above were in conformance with the rules of the Michigan Board of Land Surveyors or by a Decree of a Court of Law; established, re-established, monumented, recovered, found as expressed below:

NOTE: Not more than 2 corners, all in the same town and range, may be recorded on this certificate.

	A	B	C	D	E	F	G	H	I	J	K	L	M
1													
2		6		5		4		3		2		1	
3													
4		7		8		9		10		11		12	
5													
6		18		17		16		15		14		13	
7													
8		19		20		21		22		23		24	
9													
10		30		29		28		27		26		25	
11													
12		31		32		33		34		35		36	
13													

A. Description of original monument and accessories and/or subsequent restoration:

Original corner established by Austin Burt, U.S. Deputy Surveyor on September 8, 1846.
Original corner: Sugar Post
Original bearing trees:
Fir 10" S 46° E 4 links (2.64 feet)
Cedar 7" N 50° W 20 links (13.20 feet)

PEER GROUP APPROVED
Gary L. Pisoni 12-21-99
COUNTY REPRESENTATIVE

B. Description of corner evidence found and/or method applied in restoring or reestablishing corner:

No original corner evidence found.

Set 1/4 corner by extending range line from the W 1/4 corner of Section 30 thru the Southwest corner of Section 30 at G.L.O. distance which would be 2640 feet.


I accept this solution as the best available evidence for restoring the corner position.

Corner Record Research on file with County Representative.

C. Description of monument for corner and accessories established to perpetuate locating the position of the corner:

At the corner position, I set a 5/8" by 30" long rebar pin with a 3" cast aluminum cap, 2" above ground surface, stamped to read: Iron County Remonumentation, T42N, R34W, R33W, 1/4, S-36, S-31, 1996, RLS-27457 from which I established the following new blazed and scribed bearing trees: (all measurements taken to a nail in side of tree)

Black Spuce	5"	N 35° E	22.47 feet
White Spruce	8"	S 38° E	31.41 feet
Sugar Maple	8" Dbl.	S 06° W	34.87 feet
White Spruce	9"	S 65° W	3.11 feet
Steel Sign Post	6'	North	0.70 feet

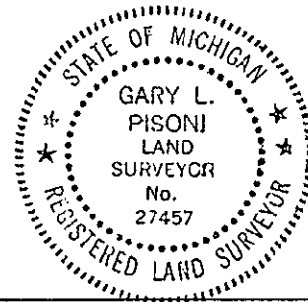

99-119

Signed by *Gary L. Pisoni*

Date 12-28-99

Surveyor's Michigan License No. 27457

FORM APPROVED BY MICHIGAN STATE BOARD OF PROFESSIONAL SURVEYORS, JAN. 28, 1971
REVISED MAY 14, 1975
REVISED JAN., 1983
REVISED OCT., 1995