

# SURVEY & REMONUMENTATION

APR 27 1995

## COMMISSION

### LAND CORNER RECORDATION CERTIFICATE Filing Requirement of Act 74, Mich. P.A. 1970

For corners in

<u>Iron</u> (County)	Located In:	Corner Code #
1. Public Land Survey	T <u>43N</u> R <u>33W</u>	<u>B-13</u>
	T <u>42N</u> R <u>33W</u>	<u>B-1</u>
	T _____ R _____	_____
	T _____ R _____	_____
2. Property Controlling in Section	S _____ T _____ R _____	_____
	S _____ T _____ R _____	_____
3. Miscellaneous Property in Sec.	S _____ T _____ R _____	_____
	S _____ T _____ R _____	_____
4. Lot No. _____, Recorded Plat _____		
5. Private Claims _____		

REGISTRAR'S OFFICE ) ..SS  
IRON COUNTY, MICH. ) ..SS  
RECEIVED FOR RECORD THE 21<sup>ST</sup> DAY OF  
FEBRUARY A.D. 19 95 AT  
2:45 O'CLOCK P. M. AND RECORDED IN LIBER  
6 OF L.C. RECORDS  
ON PAGE 361  
*Mark J. Jones*  
DEPUTY REGISTER OF DEEDS  
Register of Deeds Stamp & File Number

Quarter Corner 31 - 6 T43N R33W  
T42N

I, Gary L. Pisoni, in a field survey on Sept. 1, 19 94, do hereby certify that under requirements of P.A. 74, Michigan P.A. of 1970, the corner points mentioned in lines 1 and 2 above were in conformance with regulations and rules therefore as required in the current manual of survey instructions of the United States Department of the Interior, Bureau of Land Management or by a decree of a Court of Law and/or that the corner points mentioned in lines 3, 4 and 5 above were in conformance with the rules of the Michigan Board of Land Surveyors or by a Decree of a Court of Law; established, re-established, monumented, ~~re-monumented~~, recovered, found as expressed below:

NOTE: Not more than 4 corners, all in the same town and range, may be recorded on this certificate.

A	B	C	D	E	F	G	H	I	J	K	L	M
2	6	5	4	3	2	1						
3												
4	7	8	9	10	11	12						
5												
6	18	17	16	15	14	13						
7												
8	19	20	21	22	23	24						
9												
10	30	29	28	27	26	25						
11												
12	31	32	33	34	35	36						
13												

A. Description of original monument and accessories and/or subsequent restoration:

Original corner established by Austin Burt, U.S. Deputy Surveyor in 1846.  
Original corner: Sugar Post  
Original bearing trees:  
Aspen 8" N 16° E 35 links (23.10 feet)  
Aspen 8" N 21° W 11 links (7.26 feet)

B. Description of corner evidence found and/or method applied in restoring or reestablishing corner:

No evidence of original corner or bearing tree remains. Corner position found marked by a 1" dia. iron bar and located in the centerline of a gravel road running East and West. Corner position has been used and accepted as the corner locally for many years. Corner position checks within reason to GLO distance to the East shore of Chicagon Lake. Set an aluminum pipe monument over the top of iron bar as described below. Monument is 6" below road bed surface.

This corner is accepted as the best available evidence of the position of the original corner.


County Record Research on file with County Representative office.

PEER GROUP APPROVED  
*Alan J. Pisoni*  
COUNTY REPRESENTATIVE

C. Description of monument for corner and accessories established to perpetuate locating the position of the corner: A.P. 11-03-94

At the corner position, I set a 2" diameter by 30" long split base aluminum pipe monument with a 3" cast aluminum cap, stamped to read: Iron County Remonumentation, T43N, R33W, S-31, S-6, 1/4, T42N, 1994, RLS- 27457 from which I established the following new blazed and scribed bearing trees: (all measurements taken to a nail in side of tree)

White Birch	12" clump	West	26.38 feet
Rebar	5/8" x 30"	N 61° E	44.18 feet
Balsam	8"	N 20° W	27.42 feet
Rebar	5/8" x 30"	S 35° W	10.38 feet
Steel Sign Post		North	20.40 feet

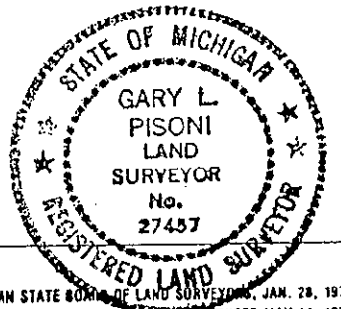

Signed by Alan J. Pisoni Date 1-9-95

Surveyor's Michigan License No. 27457