

SURVEY & REMONUMENTATION

JAN 19 1999

SECTION

LAND CORNER RECORDATION CERTIFICATE
Filing Requirement of Act 74, Mich. P.A. 1970

For corners in

<u>Iron</u> (County)	Located In:	Corner Code #
1. Public Land Survey	T <u>42N</u> R <u>R33W</u>	<u>B-5</u>
	T _____ R _____	_____
	T _____ R _____	_____
	T _____ R _____	_____
2. Property Controlling in Section	S _____ T _____ R _____	_____
	S _____ T _____ R _____	_____
3. Miscellaneous Property in Sec.	S _____ T _____ R _____	_____
	S _____ T _____ R _____	_____

IRON COUNTY MICHIGAN
RECEIVED FOR RECORD
98 DEC 28 AM 11:26
L.C. Regoels 1.7 P. 300
Robert Stiles
Register of Deeds Stamp & File Number

4. Lot No. _____, Recorded Plat _____
5. Private Claims _____

Quarter Corner Sections 7 and 18, T42N, R33W

	A	B	C	D	E	F	G	H	I	J	K	L	M
1													
2		6		5		4		3		2		1	
3													
4		7		8		9		10		11		12	
5													
6		18		17		16		15		14		13	
7													
8		19		20		21		22		23		24	
9													
10		30		29		28		27		26		25	
11													
12		31		32		33		34		35		36	
13													

I, Gary L. Pisoni, in a field survey on Dec. 9, 1998 do hereby state that under requirements of P.A. 74, Michigan P.A. of 1970, the corner points mentioned in lines 1 and 2 above were in conformance with regulations and rules therefore as required in the current manual of survey instructions of the United States Department of the Interior, Bureau of Land Management or by a decree of a Court of Law and /or that the corner points mentioned in lines 3, 4 and 5 above were in conformance with the rules of the Michigan Board of Land Surveyors or by a Decree of a Court of Law; established, re-established, monumented, recovered, found as expressed below:

NOTE: Not more than 2 corners, all in the same town and range, may be recorded on this certificate.

A. Description of original monument and accessories and/or subsequent restoration:

Original corner established in October, 1851 by Guy H. Carleton, U.S. Deputy Surveyor.
Original Corner; Wood Post
Original Bearing Trees;

Ironwood	10"	N 55° W	53 links (34.98 feet)
Lynn	16"	S 40° E	19 links (12.54 feet)

PEER GROUP APPROVED
Iron A. Pisoni 12-18-98
COUNTY REPRESENTATIVE

In 1981, Gary L. Pisoni RLS found a 1/2" diameter iron pipe, bent over, located on the South edge of County Road 424. Also found a 1" diameter iron pipe N 74°18'17"W a distance of 67.94 feet from the 1/2" diameter iron pipe. Iron pipes set by unknown persons. The 1/2" iron pipe found is on line between the Meander corner on the East shore of Indian Lake and the Southeast corner of Section 7 which was marked by an iron pipe and located in a four-way road intersection. The 1/2" diameter iron pipe is 2636.0 feet West of the Southeast corner of Section 7 and is 60 feet East from the centerline of a county road running South. I accepted the bent 1/2" diameter iron pipe as the best available evidence for restoring the quarter corner position and I replaced said pipe with a new iron pin. No bearing trees set.

In 1991, during the course of a private survey, I discovered that the iron pin located at the quarter corner was destroyed and missing due to the rebuilding of County Road 424. I reset the quarter corner position on line between the East meander corner and the Southeast corner of Section 7, at a distance of 2636.0 feet from the Southeast corner of Section 7 and marked corner position with a P.K. nail.

B. Description of corner evidence found and/or method applied in restoring or reestablishing corner:

No evidence of original B.T.s found. Found the above described P.K. nail marking corner position. Said nail is 11 feet South of the centerline of County Road 424 and 60 feet East of the centerline of a county road running South. Corner record research on file with County Representative.

C. Description of monument for corner and accessories established to perpetuate locating the position of the corner:


From the above described corner position, I set two reference monuments, being 5/8" diameter by 30" long rebar, with a 3" aluminum cap stamped as follows: Iron County Remonumentation, T42N, R33W, R.M., 1/4, S-7, S-18, S 38°W, 53.31', 1998, RLS 27457; T42N, R33W, R.M., 1/4, S-7, S-18, North, 21.29', 1998, RLS 27457 from which I blazed and scribed the following new bearing trees: (All measurements taken to a nail in side of tree)

Sugar Maple	18" dbf	N 11°W	52.90 feet
R.M.	5/8" x 30" rebar	N 38° E	53.31 feet
Sugar Maple	16"	S 41°E	46.21 feet
R.M.	5/8" x 30" rebar	South	21.29 feet
Steel sign post		South	22.38 feet

98-49
Signed by Gary L. Pisoni Date 12-21-98

Surveyor's Michigan License No. 27457

FORM APPROVED BY MICHIGAN STATE BOARD OF PROFESSIONAL SURVEYORS, JAN 28, 1971
REVISED MAY 14, 1975
REVISED JAN., 1983

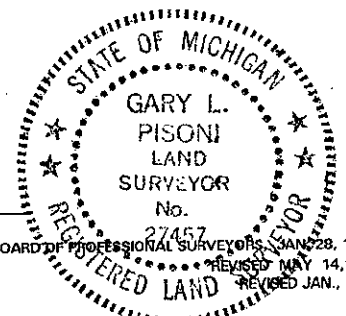

1.7 P. 300