

**SURVEY &  
REMONUMENTATION**

JAN 19 1999

**SECTION**

**LAND CORNER RECORDATION CERTIFICATE  
Filing Requirement of Act 74, Mich. P.A. 1970**

For corners in

Iron (County)	Located In:	Corner Code #
1. Public Land Survey	T <u>42N</u> R <u>33W</u>	<u>C-3</u>
	T _____ R _____	_____
	T _____ R _____	_____
	T _____ R _____	_____
2. Property Controlling in Section	S _____ T _____ R _____	_____
	S _____ T _____ R _____	_____
3. Miscellaneous Property in Sec.	S _____ T _____ R _____	_____
	S _____ T _____ R _____	_____

IRON COUNTY  
MICHIGAN  
RECEIVED FOR RECORD

98 DEC 28 AM 11:15  
L.C. Record L. 7, P. 260  
*Richard Stiles*  
RDS

Register of Deeds Stamp & File Number

4. Lot No. \_\_\_\_\_, Recorded Plat \_\_\_\_\_  
5. Private Claims \_\_\_\_\_

Section Corner Sections 5, 6, 7, 8, T42N, R33W

I, Gary L. Pisoni, in a field survey on Nov. 5, 1998 do hereby state that under requirements of P.A. 74, Michigan P.A. of 1970, the corner points mentioned in lines 1 and 2 above were in conformance with regulations and rules therefore as required in the current manual of survey instructions of the United States Department of the Interior, Bureau of Land Management or by a decree of a Court of Law and /or that the corner points mentioned in lines 3, 4 and 5 above were in conformance with the rules of the Michigan Board of Land Surveyors or by a Decree of a Court of Law; established, re-established, monumented, recovered, found as expressed below:

	A	B	C	D	E	F	G	H	I	J	K	L	M
1													
2		6		5		4		3		2		1	
3			●										
4		7		8		9		10		11		12	
5													
6		18		17		16		15		14		13	
7													
8		19		20		21		22		23		24	
9													
10		30		29		28		27		26		25	
11													
12		31		32		33		34		35		36	
13													

NOTE: Not more than 2 corners, all in the same town and range, may be recorded on this certificate.

A. Description of original monument and accessories and/or subsequent restoration:

Original corner established in October, 1851 by Guy H. Carleton, U.S. Deputy Surveyor.

Original Corner; Wood Post

Original Bearing Trees:

Sugar	12"	N 30° W	27 links (17.82 feet)
Hemlock	20"	S 60° E	32 links (21.12 feet)

PEER GROUP APPROVED  
*Gary L. Pisoni 12-18-98*  
COUNTY REPRESENTATIVE

B. Description of corner evidence found and/or method applied in restoring or reestablishing corner:

No evidence of original B.T.s found. Found a 3/4" diameter iron pipe at corner position, set by unknown persons.

I accept the iron pipe as the Section corner because it has been used for various surveys over the past 30-40 years in the area, and the section lines to the East, South, North and West have been painted and blazed from this corner position and are used as timber boundary lines and the distances to adjoining corners to the East/West and South are consistent with GLO distances.

Corner record research on file with County Representative.

C. Description of monument for corner and accessories established to perpetuate locating the position of the corner:

From the above described iron pipe, I set a 5/8" x 30" rebar inside the existing iron pipe with a 3" diameter aluminum cap stamped as follows: Iron County Remonumentation, T42N, R33W, S-5, S-6, S-7, S-8, 1998, RLS 27457 from which I established the following new blazed and scribed bearing trees: (All measurements taken to a nail in side of tree)


Hemlock	13"	N 22° W	7.09 feet
Sugar Maple	10"	N 41° E	28.61 feet
Sugar Maple	8"	S 61° E	5.96 feet
Basswood	11"	S 35° W	9.11 feet
Steel sign post		N 16° E	0.60 feet

98-34

Signed by Gary L. Pisoni Date 12-21-98

Surveyor's Michigan License No. 27457

FORM APPROVED BY MICHIGAN STATE BOARD OF PROFESSIONAL SURVEYORS, JAN. 28, 1971

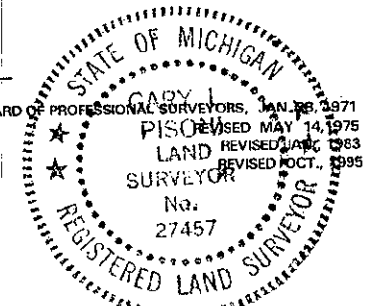

17 P. 260