

**SURVEY &
REMONUMENTATION**

JAN 19 1999

SECTION

**LAND CORNER RECORDATION CERTIFICATE
Filing Requirement of Act 74, Mich. P.A. 1970**

For corners in

<u>Iron</u> (County)	Located In:	Corner Code #
1. Public Land Survey	T <u>42N</u> R <u>33W</u>	<u>C-4</u>
	T _____ R _____	_____
	T _____ R _____	_____
	T _____ R _____	_____
2. Property Controlling in Section	S _____ T _____ R _____	_____
	S _____ T _____ R _____	_____
3. Miscellaneous Property in Sec.	S _____ T _____ R _____	_____
	S _____ T _____ R _____	_____

IRON COUNTY
MICHIGAN
RECEIVED FOR RECORD

98 DEC 28 AM 11:15
L.C. Regard: L. 7, P. 263
Gary L. Pisoni
REGISTER OF DEEDS
Register of Deeds Stamp & File Number

4. Lot No. _____, Recorded Plat _____
5. Private Claims _____

Quarter Corner Sections 7 and 8, T42N, R33W

I, Gary L. Pisoni, in a field survey on Nov. 5, 1998 do hereby state that under requirements of P.A. 74, Michigan P.A. of 1970, the corner points mentioned in lines 1 and 2 above were in conformance with regulations and rules therefore as required in the current manual of survey instructions of the United States Department of the Interior, Bureau of Land Management or by a decree of a Court of Law and/or that the corner points mentioned in lines 3, 4 and 5 above were in conformance with the rules of the Michigan Board of Land Surveyors or by a Decree of a Court of Law; established, re-established, monumented, recovered, found as expressed below:

NOTE: Not more than 2 corners, all in the same town and range, may be recorded on this certificate.

	A	B	C	D	E	F	G	H	I	J	K	L	M
1													
2		6		5		4		3		2		1	
3													
4		7	●	8		9		10		11		12	
5													
6		18		17		16		15		14		13	
7													
8		19		20		21		22		23		24	
9													
10		30		29		28		27		26		25	
11													
12		31		32		33		34		35		36	
13													

A. Description of original monument and accessories and/or subsequent restoration:

Original corner established in October, 1851 by Guy H. Carleton, U.S. Deputy Surveyor.
Original Corner; Wood Post
Original Bearing Trees:
Sugar 12" S 55° W 56 links (36.96feet)
Sugar 12" N 45° E 42 links (27.72 feet)

PEER GROUP APPROVED
Gary L. Pisoni 12-12-98
COUNTY REPRESENTATIVE

B. Description of corner evidence found and/or method applied in restoring or reestablishing corner:

No evidence of original B.T.s found. Found a 5/8" x 30" rebar pin marking corner position which I previously set on 9/9/81 on line and midway between the Northeast corner of Section 7 and the Southeast corner of Section 7.

The distances along the Section line are consistent with GLO distances.


I accept the rebar pin as the best available evidence for restoring the corner position.
Rebar pin located on the East edge of a county road running North and South, said pin is 8" below roadbed surface.

Corner record research on file with County Representative.

C. Description of monument for corner and accessories established to perpetuate locating the position of the corner:

At the corner position, set a 3" diameter aluminum cap over the top of the existing rebar pin and stamped as follows:
Iron County Remonumentation, T42N, R33W, 1/4, S-7, S-8, 1998, RLS 27457 from which I established the following new blazed and scribed bearing trees: (All measurements taken to a nail in side of tree)

Sugar Maple	11"	N 24° W	78.34 feet
Black Cherry	8"	N 81° E	31.03 feet
Basswood	9"	S 16° E	56.06 feet
Sugar Maple	8"	S 81° W	74.15 feet
Centerline of county road		West	12.00 feet
Steel sign post		N 81° E	24.1 feet

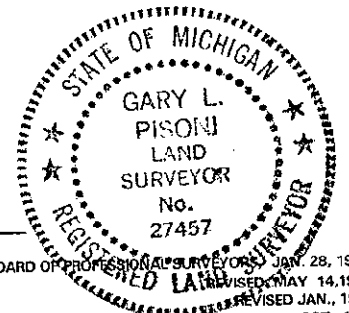

98-43
Signed by Gary L. Pisoni Date 12-21-98

Surveyor's Michigan License No. 27457

L. 7 P. 263