

SURVEY & REMONUMENTATION

JAN 19 1999

SECTION

LAND CORNER RECORDATION CERTIFICATE
Filing Requirement of Act 74, Mich. P.A. 1970

For corners in

Iron (County)	Located In:	Corner Code #
1. Public Land Survey	T <u>42N</u> R <u>33W</u>	<u>E-5</u>
	T _____ R _____	_____
	T _____ R _____	_____
	T _____ R _____	_____
2. Property Controlling in Section	S _____ T _____ R _____	_____
	S _____ T _____ R _____	_____
3. Miscellaneous Property in Sec.	S _____ T _____ R _____	_____
	S _____ T _____ R _____	_____

IRON COUNTY
MICHIGAN
RECEIVED FOR RECORD

98 DEC 28 AM 11:16

L.C. Records: L.7, P. 266

Richard L. Pisoni

Register of Deeds Stamp & File Number

4. Lot No. _____, Recorded Plat _____
5. Private Claims _____

Section Corner Sections 8, 9, 17, 16, T42N, R33W

I, Gary L. Pisoni, in a field survey on Nov. 5, 1998 do hereby state that under requirements of P.A. 74, Michigan P.A. of 1970, the corner points mentioned in lines 1 and 2 above were in conformance with regulations and rules therefore as required in the current manual of survey instructions of the United States Department of the Interior, Bureau of Land Management or by a decree of a Court of Law and /or that the corner points mentioned in lines 3, 4 and 5 above were in conformance with the rules of the Michigan Board of Land Surveyors or by a Decree of a Court of Law; established, re-established, monumented, recovered, found as expressed below:

	A	B	C	D	E	F	G	H	I	J	K	L	M
1													
2	6			5			4		3			2	1
3													
4	7						9		10			11	12
5					●								
6	18			17			16		15			14	13
7													
8	19			20			21		22			23	24
9													
10	30			29			28		27			26	25
11													
12	31			32			33		34			35	36
13													

NOTE: Not more than 2 corners, all in the same town and range, may be recorded on this certificate.

A. Description of original monument and accessories and/or subsequent restoration:

Original corner established in October, 1851 by Guy H. Carleton, U.S. Deputy Surveyor.
Original Corner; Wood Post
Original Bearing Trees:
Fir 10" S 75° E 19 links (12.54 feet)
Fir 11" N 20° W 15 links (9.90 feet)

B. Description of corner evidence found and/or method applied in restoring or reestablishing corner:

No evidence of original B.T.s found. Found a 1" diameter iron pipe, 3' above ground surface marking corner position located on an old fence line which runs East, West and South. Corner has been in existence for over 50 years.

I accept the iron pipe as the best available evidence for restoring the corner position.
Iron pipe is located on the South edge of a private access road.

Distances to adjoining corners are consistent with GLO distances.

Corner record research on file with County Representative.

PEER GROUP APPROVED
Iron A. Pisoni 12-18-98
COUNTY REPRESENTATIVE

C. Description of monument for corner and accessories established to perpetuate locating the position of the corner:


At the corner position, I replaced the iron pipe with a 3/4" diameter aluminum rod monument, 3" above ground surface with a 3" diameter aluminum cap stamped as follows: Iron County Remonumentation, T42N, R33W, S-8, S-9, S-16, S-17, 1998, RLS 27457 from which I established the following new blazed and scribed bearing trees: (All measurements taken to a nail in side of tree)

White Pine	8"	N 68° W	49.81 feet
Red Maple	10"	N 46° E	55.84 feet
Red Maple	8"	S 85° E	26.55 feet
White Birch	10"	S 30° W	8.47 feet
Steel sign post		S 30° W	0.7 feet

98-52
Signed by Gary L. Pisoni
Surveyor's Michigan License No. 27457

Date 12-21-98

FORM APPROVED BY MICHIGAN STATE BOARD OF PROFESSIONAL SURVEYORS, JAN. 28, 1971
REVISED MAY 14, 1975
REVISED JAN., 1993
REVISED OCT., 1995

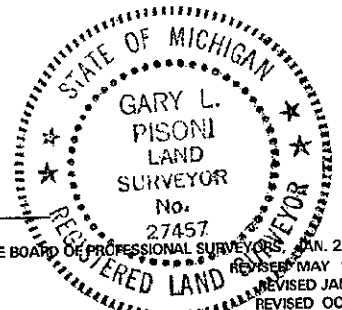

L.7 P. 266