

SURVEY & REMONUMENTATION

FORM NO. 985-A



Stock No. 26273

MAR 19 1997

COMMISSION LAND CORNER RECORDATION CERTIFICATE Filing Requirement of Act 74, Mich. P.A. 1970

For corners in

<u>Iron</u> (County)	Located In:	Corner Code #
1. Public Land Survey	T <u>42N</u> R <u>33W</u>	<u>F-9</u>
	T _____ R _____	_____
	T _____ R _____	_____
	T _____ R _____	_____
2. Property Controlling in Section	S _____ T _____ R _____	_____
	S _____ T _____ R _____	_____
3. Miscellaneous Property in Sec.	S _____ T _____ R _____	_____
	S _____ T _____ R _____	_____

IRON COUNTY MICHIGAN
RECEIVED FOR RECORD

96 DEC 23 AM 9:10

L.C. Records L. 7, P. 61

Carlton J. Pisoni
REGISTERED LAND SURVEYOR

Register of Deeds Stamp & File Number

4. Lot No. _____, Recorded Plat _____
5. Private Claims _____

Quarter Corner and Meander Corner between Sections 21 & 28, T42N R33W

I, Gary L. Pisoni, in a field survey on November 12, 1996 do hereby state that under requirements of P.A. 74, Michigan P.A. of 1970, the corner points mentioned in lines 1 and 2 above were in conformance with regulations and rules therefore as required in the current manual of survey instructions of the United States Department of the Interior, Bureau of Land Management or by a decree of a Court of Law and /or that the corner points mentioned in lines 3, 4 and 5 above were in conformance with the rules of the Michigan Board of Land Surveyors or by a Decree of a Court of Law; established, re-established, monumented, recovered, found as expressed below:

A	B	C	D	E	F	G	H	I	J	K	L	M
1												
2	6		5		4		3		2		1	
3												
4	7		8		9		10		11		12	
5												
6	18		17		16		15		14		13	
7												
8	19		20		21		22		23		24	
9												
10	30		29		28		27		26		25	
11												
12	31		32		33		34		35		36	
13												

NOTE: Not more than 2 corners, all in the same town and range, may be recorded on this certificate.

A. Description of original monument and accessories and/or subsequent restoration:

Original corner established by Guy H. Carleton, U.S. Deputy Surveyor in 1851.
Original corner: Wood Post
Original bearing trees:
Maple 12" N 15° W 34 links (22.44 feet)
White Pine 10" N 55° W 15 links (9.90 feet)

In 1948, Bureau of Land Management set a 6" dia. concrete monument with brass cap from a dependent resurvey of Sections 28 & 29, T42N R33W stamped to read: U.S. General Land Office Survey, T42N, 1/4, S-21, S-28, M.C., R33W, 1948.

1948 bearing trees:
White Birch 8" S 71 3/4° W 177.5 links (117.15 feet)
White Pine 16" N 30° W 255.5 links (168.63 feet)


B. Description of corner evidence found and/or method applied in restoring or reestablishing corner:

Found monument as described above.
Corner position is a quarter corner and a meander corner. Monument is 15 feet from waters edge.
Corner Record Research on file with County Representative.

PEER GROUP APPROVED
per Gary L. Pisoni 12-11-96
COUNTY REPRESENTATIVE

C. Description of monument for corner and accessories established to perpetuate locating the position of the corner:

Blazed and scribed the following new bearing trees: (all measurements taken to a nail in side of tree)
Balsam 4" N 80° W 4.06 feet
Willow 6" Clump N 87° E 4.86 feet
Willow 12" S 16° W 44.77 feet
Steel Sign Post 6' N 40° E 0.65 feet

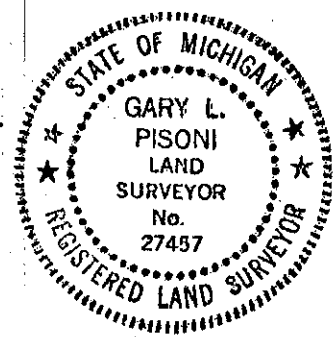

#96-39
Signed by Gary L. Pisoni Date 12-10-96
Surveyor's Michigan License No. 27457

L. 7 P. 61