



SURVEY & REMONUMENTATION

Stock No. 26273

MAR 19 1997

COMMISSION LAND CORNER RECORDATION CERTIFICATE Filing Requirement of Act 74, Mich. P.A. 1970

For corners in

<u>Iron</u> (County)	Located In:	Corner Code #
1. Public Land Survey	T <u>42N</u> R <u>R33W</u>	<u>F-11</u>
	T _____ R _____	_____
	T _____ R _____	_____
	T _____ R _____	_____
2. Property Controlling in Section	S _____ T _____ R _____	_____
	S _____ T _____ R _____	_____
3. Miscellaneous Property in Sec.	S _____ T _____ R _____	_____
	S _____ T _____ R _____	_____

IRON COUNTY MICHIGAN RECEIVED FOR RECORD

96 DEC 23 AM 9:09
L.C. Records L. 7, P. 59
Gilbert J. Pisoni
REGISTERED DEEDS

Register of Deeds Stamp & File Number

4. Lot No. _____, Recorded Plat _____
5. Private Claims _____

Quarter Corner between Sections 28 & 33, T42N R33W

I, Gary L. Pisoni, in a field survey on November 12, 1996 do hereby state that under requirements of P.A. 74, Michigan P.A. of 1970, the corner points mentioned in lines 1 and 2 above were in conformance with regulations and rules therefore as required in the current manual of survey instructions of the United States Department of the Interior, Bureau of Land Management or by a decree of a Court of Law and /or that the corner points mentioned in lines 3, 4 and 5 above were in conformance with the rules of the Michigan Board of Land Surveyors or by a Decree of a Court of Law; established, re-established, monumented, recovered, found as expressed below:

NOTE: Not more than 2 corners, all in the same town and range, may be recorded on this certificate.

	A	B	C	D	E	F	G	H	I	J	K	L	M
1													
2		6		5		4		3		2		1	
3													
4		7		8		9		10		11		12	
5													
6		18		17		16		15		14		13	
7													
8		19		20		21		22		23		24	
9													
10		30		29		28		27		26		25	
11													
12		31		32		33		34		35		36	
13													

A. Description of original monument and accessories and/or subsequent restoration:

Original corner established by Guy H. Carleton, U.S. Deputy Surveyor in 1851.
Original corner: Wood Post
Original bearing trees:

Cedar	8"	S 08° W	14 links (9.24 feet)
Cedar	8"	N 08° E	14 links (9.24 feet)

B. Description of corner evidence found and/or method applied in restoring or reestablishing corner:


No original corner evidence found.
Found a 1" by 5' long drill rod marking corner position located in a black spruce swamp.
Accepted drill rod as the best available-evidence for restoring corner position.
Corner Record Research on file with County Representative.

PEER GROUP APPROVED
Iron Gary L. Pisoni 12-11-96
COUNTY REPRESENTATIVE

C. Description of monument for corner and accessories established to perpetuate locating the position of the corner:

Replaced drill rod and set a 3/4" outside diameter by 4 feet long aluminum rod monument with a 3" cast aluminum cap, stamped to read: Iron County Remonumentation, T42N, R33W, 1/4, S-28, S-33, 1996, RLS-27457 from which I established the following new blazed and scribed bearing trees: (all measurements taken to a nail in side of tree)

Black Spruce	10"	N 21° W	49.25 feet
Black Spruce	12"	S 77° E	48.36 feet
Black Spruce	8"	S 42° W	33.68 feet
Black Spruce	10"	N 74° W	39.50 feet
Steel Sign Post	6'	South	0.65 feet

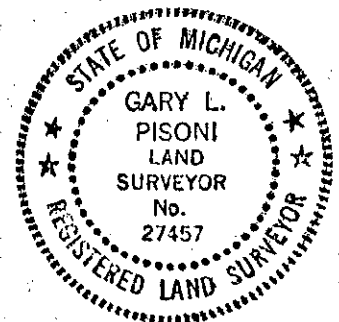

#96-37
Signed by *Gary L. Pisoni* Date 12-10-96
Surveyor's Michigan License No. 27457

L. 7 P. 59