

# SURVEY & REMONUMENTATION

FORM NO. 985-A



Stock No. 26273

MAR 19 1997

COMMISSION

## LAND CORNER RECORDATION CERTIFICATE Filing Requirement of Act 74, Mich. P.A. 1970

For corners in

<u>Iron</u> (County)	Located In:	Corner Code #	
1. Public Land Survey	T <u>42N</u> R <u>33W</u>	<u>G-13</u>	
	T <u>41N</u> R <u>33W</u>	<u>G-1</u>	
	T _____ R _____	_____	_____
	T _____ R _____	_____	_____
2. Property Controlling in Section	S _____ T _____ R _____	_____	_____
	S _____ T _____ R _____	_____	_____
3. Miscellaneous Property in Sec.	S _____ T _____ R _____	_____	_____
	S _____ T _____ R _____	_____	_____

IRON COUNTY  
MICHIGAN  
RECEIVED FOR RECORD

96 DEC 23 AM 9:11  
*L.C. Segarda L.R., P. 64*  
*Register of Deeds*

Register of Deeds Stamp & File Number

4. Lot No. \_\_\_\_\_, Recorded Plat \_\_\_\_\_  
5. Private Claims \_\_\_\_\_

Section Corner 33 & 34, T42N R33W  
4 & 3, T41N R33W

I, Gary L. Pisoni, in a field survey on November 13, 1996 do hereby state that under requirements of P.A. 74, Michigan P.A. of 1970, the corner points mentioned in lines 1 and 2 above were in conformance with regulations and rules therefore as required in the current manual of survey instructions of the United States Department of the Interior, Bureau of Land Management or by a decree of a Court of Law and/or that the corner points mentioned in lines 3, 4 and 5 above were in conformance with the rules of the Michigan Board of Land Surveyors or by a Decree of a Court of Law; established, re-established, monumented, recovered, found as expressed below:

NOTE: Not more than 2 corners, all in the same town and range, may be recorded on this certificate.

	A	B	C	D	E	F	G	H	I	J	K	L	M
1													
2	6		5		4		3		2		1		
3													
4	7		8		9		10		11		12		
5													
6	18		17		16		15		14		13		
7													
8	19		20		21		22		23		24		
9													
10	30		29		28		27		26		25		
11													
12	31		32		33		34		35		36		
13													

A. Description of original monument and accessories and/or subsequent restoration:

Original corner established by Austin Burt, U.S. Deputy Surveyor on July 31, 1846.

Original corner: Wood Post

Original bearing trees:

White Pine	16"	N 67° E	34 links (22.44 feet)
White Pine	24"	N 66° W	11 links (7.26 feet)
White Pine	18"	S 52° E	17 links (11.22 feet)
Fir	10"	S 67° W	20 links (13.20 feet)

PEER GROUP APPROVED

*2000 Gary L. Pisoni 12/11/96*  
COUNTY REPRESENTATIVE

B. Description of corner evidence found and/or method applied in restoring or reestablishing corner:

No original corner evidence found.

Found a 1 1/2" dia. Iron pipe marking corner position. GLO distance West and South to Brule River check very close.


I accept the iron pipe as the best available evidence for restoring corner position.

Corner Record Research on file with County Representative.

C. Description of monument for corner and accessories established to perpetuate locating the position of the corner:

Inside the existing iron pipe, I set a 3/4" outside diameter by 3 feet long aluminum rod monument with a 3" cast aluminum cap, stamped to read: Iron County Remonumentation, T42N, R33W, S-33, S-34, S-4, S-3, T41N, 1996, RLS-27457 from which I established the following new blazed and scribed bearing trees: (all measurements taken to a nail in side of tree)

White Spruce	10"	N 10° E	35.41 feet
Red Maple	6"	S 80° E	29.88 feet
Ash	7"	S 30° W	29.65 feet
Ash	9"	S 86° W	31.96 feet
Steel Sign Post	6'	South	0.75 feet

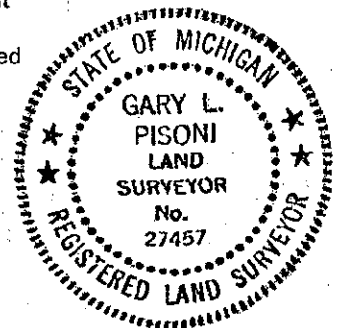

#96-42

Signed by Gary L. Pisoni

Date 12-10-96

Surveyor's Michigan License No. 27457

FORM APPROVED BY MICHIGAN STATE BOARD OF PROFESSIONAL SURVEYORS, JAN. 28, 1971  
REVISED MAY 14, 1975  
REVISED JAN., 1983  
REVISED OCT., 1995

*L.7 P.64*