

SURVEY & REMONUMENTATION

FORM NO. 985-A



Stock No. 26273

MAR 19 1997

COMMISSION

LAND CORNER RECORDATION CERTIFICATE Filing Requirement of Act 74, Mich. P.A. 1970

For corners in

<u>Iron</u> (County)	Located in:	Corner Code #
1. Public Land Survey	T <u>42N</u> R <u>R33W</u>	<u>H-9</u>
	T _____ R _____	_____
	T _____ R _____	_____
	T _____ R _____	_____
2. Property Controlling in Section	S _____ T _____ R _____	_____
	S _____ T _____ R _____	_____
3. Miscellaneous Property in Sec.	S _____ T _____ R _____	_____
	S _____ T _____ R _____	_____

IRON COUNTY
MICHIGAN
RECEIVED FOR RECORD

96 DEC 23 AM 9:17
L.C. Records L.7, P. 81
G. L. Pisoni
REGISTERED LAND SURVEYOR

Register of Deeds Stamp & File Number

4. Lot No. _____, Recorded Plat _____
5. Private Claims _____

Quarter Corner between Sections 22 & 27, T42N R33W

I, Gary L. Pisoni, in a field survey on November 20, 1996 do hereby state that under requirements of P.A. 74, Michigan P.A. of 1970, the corner points mentioned in lines 1 and 2 above were in conformance with regulations and rules therefore as required in the current manual of survey instructions of the United States Department of the Interior, Bureau of Land Management or by a decree of a Court of Law and /or that the corner points mentioned in lines 3, 4 and 5 above were in conformance with the rules of the Michigan Board of Land Surveyors or by a Decree of a Court of Law; established, re-established, monumented, recovered, found as expressed below:

A	B	C	D	E	F	G	H	I	J	K	L	M
1												
2	6	5			4		3		2		1	
3												
4	7	8			9		10		11		12	
5												
6	18	17			16		15		14		13	
7												
8	19	20			21		22		23		24	
9												
10	30	29			28		27		26		25	
11												
12	31	32			33		34		35		36	
13												

NOTE: Not more than 2 corners, all in the same town and range, may be recorded on this certificate.

A. Description of original monument and accessories and/or subsequent restoration:

Original corner established by Guy H. Carleton, U.S. Deputy Surveyor in 1851.
Original corner: Wood Post
Original bearing trees:
Fir 12" S 69° E 21 links (13.86 feet)
Fir 8" N 32° W 12 links (7.92 feet)

B. Description of corner evidence found and/or method applied in restoring or reestablishing corner:

No original corner evidence found.
Accept the intersection of the centerline of Rainbow Trail and an old wire fence line running North and South as the best available evidence for restoring the Quarter corner position.


Corner Record Research on file with County Representative.

C. Description of monument for corner and accessories established to perpetuate locating the position of the corner:

At the corner position, I set a 5/8" by 30" long rebar pin with a 3" cast aluminum cap, 6" below road bed surface, stamped to read: Iron County Remonumentation, T42N, R33W, 1/4, S-22, S-27, 1996, RLS - 27457 from which I established the following new blazed and scribed bearing trees: (all measurements taken to a nail in side of tree)

Reference Monument	3/4" x 36" aluminum rod with cap	North	20.96 feet
Black Cherry	8"	N 19 E	38.42 feet
Utility Pole	#N72-1556	S 12 E	28.90 feet
Tamarack	10"	S 37 W	67.80 feet
Steel Sign Post	6'	North	21.61 feet

PEER GROUP APPROVED
Gary L. Pisoni 12/1/96
COUNTY REPRESENTATIVE

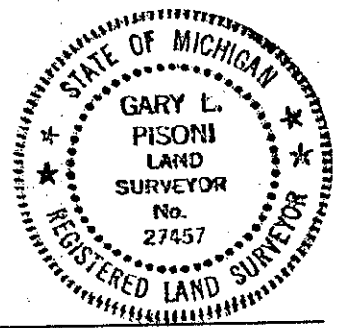

#96-59
Signed by Gary L. Pisoni
Surveyor's Michigan License No. 27457

Date 12-10-96

L.7 P. 81