

**SURVEY & REMONUMENTATION**

JAN 19 1999

**SECTION**

**LAND CORNER RECORDATION CERTIFICATE**  
Filing Requirement of Act 74, Mich. P.A. 1970

For corners in

Iron	Located In:	Corner Code #
(County)		
1. Public Land Survey	T <u>42N</u> R <u>33W</u>	<u>1-5</u>
	T _____ R _____	_____
	T _____ R _____	_____
	T _____ R _____	_____
2. Property Controlling in Section	S _____ T _____ R _____	_____
	S _____ T _____ R _____	_____
3. Miscellaneous Property in Sec.	S _____ T _____ R _____	_____
	S _____ T _____ R _____	_____

IRON COUNTY  
MICHIGAN  
RECEIVED FOR RECORD

98 DEC 28 AM 11:17

*L.C. Register L. 7, P. 270*

*Edward Stiles*

Register of Deeds Stamp & File Number

4. Lot No. \_\_\_\_\_, Recorded Plat \_\_\_\_\_

5. Private Claims \_\_\_\_\_

Section Corner Sections 10, 11, 15, 14, T42N, R33W

I, Gary L. Pisoni, in a field survey on Nov. 7, 1998 do hereby state that under requirements of P.A. 74, Michigan P.A. of 1970, the corner points mentioned in lines 1 and 2 above were in conformance with regulations and rules therefore as required in the current manual of survey instructions of the United States Department of the Interior, Bureau of Land Management or by a decree of a Court of Law and /or that the corner points mentioned in lines 3, 4 and 5 above were in conformance with the rules of the Michigan Board of Land Surveyors or by a Decree of a Court of Law; established, re-established, monumented, recovered, found as expressed below:

	A	B	C	D	E	F	G	H	I	J	K	L	M
1													
2	6		5		4		3		2		1		
3													
4	7		8		9		10		11		12		
5								●					
6	18		17		16		15		14		13		
7													
8	19		20		21		22		23		24		
9													
10	30		29		28		27		26		25		
11													
12	31		32		33		34		35		36		
13													

**NOTE:** Not more than 2 corners, all in the same town and range, may be recorded on this certificate.

**A. Description of original monument and accessories and/or subsequent restoration:**

Original corner established in October, 1851 by Guy H. Carleton, U.S. Deputy Surveyor.  
Original Corner; Wood Post  
Original Bearing Trees;

Sugar	14"	N 20°E	20 links (13.20 feet)
Sugar	10"	S 20°W	19 links (12.54 feet)

PEER COUNTY APPROVED  
Iron H. Pisoni 13-18-98  
COUNTY REPRESENTATIVE

**B. Description of corner evidence found and/or method applied in restoring or reestablishing corner:**

No evidence of original B.T.s found. Found a 1 1/4" diameter iron pipe located at a rock fence corner which runs North and West, and in line with the centerline of a County Road to the South. I accept the iron pipe as the best available evidence for restoring the corner position.

Distances to adjoining corners are consistent with GLO distances.

Corner record research on file with County Representative.


**C. Description of monument for corner and accessories established to perpetuate locating the position of the corner:**

Replaced iron pipe with a 3/4" diameter aluminum rod monument, 3 feet long with a 3" diameter aluminum cap stamped as follows: Iron County Remonumentation, T42N, R33W, S-10, S-11, S-14, S-15, 1998, RLS 27457 from which I established the following new blazed and scribed bearing trees: (All measurements taken to a nail in side of tree)

Basswood	15"	N 26°E	29.70 feet
Sugar Maple	8"	S 50°E	36.60 feet
Sugar Maple	10"	S 30°W	39.30 feet
Utility Pole #N72-1563		S 84°W	34.20 feet
Steel sign post		North	0.80 feet

98-56  
Signed by Gary L. Pisoni Date 12-21-98  
Surveyor's Michigan License No. 27457

FORM APPROVED BY MICHIGAN STATE BOARD OF PROFESSIONAL SURVEYORS, JAN. 28, 1971  
REVISED MAY 14, 1975  
REVISED JAN., 1983  
REVISED OCT., 1995

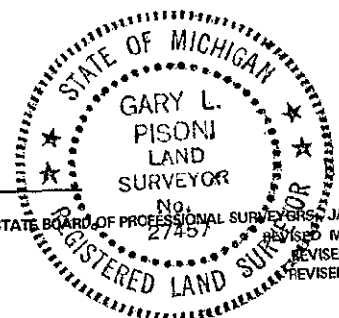

L. 7 P. 270