

SURVEY & REMONUMENTATION

FORM NO. 985-A



Stock No. 26273

MAR 19 1997

COMMISSION

LAND CORNER RECORDATION CERTIFICATE Filing Requirement of Act 74, Mich. P.A. 1970

For corners in

_____ Iron _____ (County)	Located In:	Corner Code #
1. Public Land Survey	T <u>42N R 33W</u>	<u>1-13</u>
	T <u>41N R 33W</u>	<u>-1</u>
	T _____ R _____	_____
	T _____ R _____	_____
2. Property Controlling in Section	S _____ T _____ R _____	_____
	S _____ T _____ R _____	_____
3. Miscellaneous Property in Sec.	S _____ T _____ R _____	_____
	S _____ T _____ R _____	_____

IRON COUNTY MICHIGAN RECEIVED FOR RECORD

96 DEC 23 AM 9:12

L.C. Records L. 7, P. 68

Gary L. Pisoni
REGISTER OF DEEDS

Register of Deeds Stamp & File Number

4. Lot No. _____, Recorded Plat _____
5. Private Claims _____

Section Corner 34 & 35, T42N R33W
3 & 2, T41N R33W

I, Gary L. Pisoni, in a field survey on November 19, 1996 do hereby state that under requirements of P.A. 74, Michigan P.A. of 1970, the corner points mentioned in lines 1 and 2 above were in conformance with regulations and rules therefore as required in the current manual of survey instructions of the United States Department of the Interior, Bureau of Land Management or by a decree of a Court of Law and /or that the corner points mentioned in lines 3, 4 and 5 above were in conformance with the rules of the Michigan Board of Land Surveyors or by a Decree of a Court of Law; established, re-established, monumented, recovered, found as expressed below:

A	B	C	D	E	F	G	H	I	J	K	L	M
1												
2	6		5		4		3		2		1	
3												
4	7		8		9		10		11		12	
5												
6	18		17		16		15		14		13	
7												
8	19		20		21		22		23		24	
9												
10	30		29		28		27		26		25	
11												
12	31		32		33		34		35		36	
13												

NOTE: Not more than 2 corners, all in the same town and range, may be recorded on this certificate.

A. Description of original monument and accessories and/or subsequent restoration:

Original corner established by Austin Burt., U.S. Deputy Surveyor on July 31, 1846.

Original corner: Wood Post

Original bearing trees:

White Pine	16"	S 03° E	24 links (15.84 feet)
Yellow Pine	18"	S 29° W	31 links (20.46 feet)
White Pine	14"	N 10° W	25 links (16.50 feet)
White Pine	6"	N 27° E	34 links (22.44 feet)

B. Description of corner evidence found and/or method applied in restoring or reestablishing corner:

No original corner evidence found. Area was heavily burned in early 1900's.

Found a wood post located on South end of a wire fence line which has been used as the section corner, but post is too far out of position to be acceptable as the section corner. The wood post on the fence line is S 58°28'E and 235.26 feet from another wood post found lying on ground which is the section corner position. Post found is 5" in dia. and marking corner position.

From wood post, GLO distances East, West, North and South check good to other GLO corners.

I accept the wood post as the best available evidence for restoring corner position.


Corner Record Research on file with County Representative.

PEER GROUP APPROVED
Iron Gary L. Pisoni 12-11-96
COUNTY REPRESENTATIVE

C. Description of monument for corner and accessories established to perpetuate locating the position of the corner:

Replaced wood post and set a 2" diameter by 30" long split base aluminum pipe monument with a 3" cast aluminum cap, stamped to read: Iron County Remonumentation, T42N, R33W, S-34, S-35, S-3, S-2, T41N, 1996, RLS-27457 from which I established the following new blazed and scribed bearing trees: (all measurements taken to a nail in side of tree)

Black Cherry	6" Clump	N 31° E	65.96 feet
Black Cherry	6" Clump	N 85° E	88.98 feet
Aspen	8"	S 25° W	55.50 feet
Aspen	7"	N 32° W	55.24 feet
Wood Post on fence line 5" dia.		S 58° 28'E	235.26 feet
Steel Sign Post	6'	West	0.98 feet

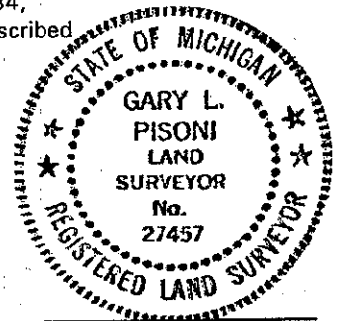

#96-46
Signed by *Gary L. Pisoni* Date 12-10-96

Surveyor's Michigan License No. 27457

L. 7 P. 68