

# SURVEY & REMONUMENTATION

FORM NO. 985-A



Stock No. 26273

MAR 19 1997

COMMISSION

## LAND CORNER RECORDATION CERTIFICATE Filing Requirement of Act 74, Mich. P.A. 1970

For corners in

Iron <small>(County)</small>	Located In:	Corner Code #
1. Public Land Survey	T <u>42N</u> R <u>R33W</u>	<u>J-7</u>
	T _____ R _____	_____
	T _____ R _____	_____
	T _____ R _____	_____
2. Property Controlling in Section	S _____ T _____ R _____	_____
	S _____ T _____ R _____	_____
3. Miscellaneous Property in Sec.	S _____ T _____ R _____	_____
	S _____ T _____ R _____	_____

IRON COUNTY MICHIGAN  
RECEIVED FOR RECORD

96 DEC 23 AM 9:22  
*L.C. Records L. 7, P. 96*  
*Carlton Pisoni*  
REGISTERED DEEDS

Register of Deeds Stamp & File Number

4. Lot No. \_\_\_\_\_, Recorded Plat \_\_\_\_\_  
5. Private Claims \_\_\_\_\_

Quarter Corner between Sections 14 & 23, T42N R33W

I, Gary L. Pisoni, in a field survey on November 22, 1996 do hereby state that under requirements of P.A. 74, Michigan P.A. of 1970, the corner points mentioned in lines 1 and 2 above were in conformance with regulations and rules therefore as required in the current manual of survey instructions of the United States Department of the Interior, Bureau of Land Management or by a decree of a Court of Law and /or that the corner points mentioned in lines 3, 4 and 5 above were in conformance with the rules of the Michigan Board of Land Surveyors or by a Decree of a Court of Law; established, re-established, monumented, recovered, found as expressed below:

NOTE: Not more than 2 corners, all in the same town and range, may be recorded on this certificate.

	A	B	C	D	E	F	G	H	I	J	K	L	M
1													
2	6		5		4		3		2		1		
3													
4	7		8		9		10		11		12		
5													
6	18		17		16		15		14		13		
7									●				
8	19		20		21		22		23		24		
9													
10	30		29		28		27		26		25		
11													
12	31		32		33		34		35		36		
13													

A. Description of original monument and accessories and/or subsequent restoration:

Original corner established by Guy H. Carleton, U.S. Deputy Surveyor in 1851.  
Original corner: Wood Post  
Original bearing trees:

Elm	14"	S 05° E	10 links ( 6.60 feet)
Sugar	10"	N 15° E	13 links ( 8.58 feet)

B. Description of corner evidence found and/or method applied in restoring or reestablishing corner:

No original corner evidence found.

Accept the intersection of the centerline of Carney Dam road to the South and an old wire fence line running West as the best available evidence for restoring corner position.

Corner Record Research on file with County Representative.


PEER GROUP APPROVED

*Iron Gary L. Pisoni 12-11-96*  
COUNTY REPRESENTATIVE

C. Description of monument for corner and accessories established to perpetuate locating the position of the corner:

At the corner position, I set a 3/4" outside diameter by 3 feet long aluminum rod monument with a 3" cast aluminum cap, stamped to read: Iron County Remonumentation, T42N, R33W, 1/4, S-14, S-23, 1996, RLS-27457 from which I established the following new blazed and scribed bearing trees: (all measurements taken to a nail in side of tree)

Utility Pole	#95-07321	N 69° E	15.75 feet
Rebar	5/8" x 30"	S 34° E	71.32 feet
Black Cherry	8"	S 57° W	74.50 feet
Utility Pole	#93-21988	N 58° W	41.71 feet
Steel Sign Post	6'	North	1.50 feet

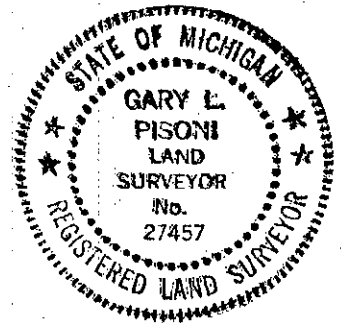

#96-74

Signed by *Gary L. Pisoni*

Date 12-10-96

Surveyor's Michigan License No. 27457

*L. 7 P. 96*