

SURVEY & REMONUMENTATION

JAN 13 1998

SECTION

LAND CORNER RECORDATION CERTIFICATE
Filing Requirement of Act 74, Mich. P.A. 1970

IRON COUNTY
MICHIGAN
RECEIVED FOR RECORD

97 DEC 23 PM 1:31
L.C. Records L.P. 175

Gary L. Pisoni
REGISTER OF DEEDS

For corners in

Iron
(County)

Located In:

Corner Code #

1. Public Land Survey

T 42N R 33W

K-1

T 43N R 33W

K-13

T _____ R _____

T _____ R _____

2. Property Controlling in Section

S _____ T _____ R _____

3. Miscellaneous Property in Sec.

S _____ T _____ R _____

S _____ T _____ R _____

Register of Deeds Stamp & File Number

4. Lot No. _____, Recorded Plat _____

5. Private Claims _____

Section Corner Sections 35, 36, T43N, R33W
Sections 2, 1, T42N, R33W

I, Gary L. Pisoni, in a field survey on December 8, 1997 do hereby state that under requirements of P.A. 74, Michigan P.A. of 1970, the corner points mentioned in lines 1 and 2 above were in conformance with regulations and rules therefore as required in the current manual of survey instructions of the United States Department of the Interior, Bureau of Land Management or by a decree of a Court of Law and/or that the corner points mentioned in lines 3, 4 and 5 above were in conformance with the rules of the Michigan Board of Land Surveyors or by a Decree of a Court of Law; established, re-established, monumented, recovered, found as expressed below:

NOTE: Not more than 2 corners, all in the same town and range, may be recorded on this certificate.

A	B	C	D	E	F	G	H	I	J	K	L	M
1												
2	6	5	4	3	2							
3												
4	7	8	9	10	11	12						
5												
6	18	17	16	15	14	13						
7												
8	19	20	21	22	23	24						
9												
10	30	29	28	27	26	25						
11												
12	31	32	33	34	35	36						
13												

A. Description of original monument and accessories and/or subsequent restoration:
Original Corner established in 1846 by Austin Burt, U.S. Deputy Surveyor.
Original Corner: Cedar Post
Original Bearing Trees:

Sugar	16"	N 61° E	40 lks (26.40 feet)
Yellow Birch	14"	N 18° W	17 lks (11.22 feet)
In 1851, Guy H. Carleton established the following bearing trees:			
Yellow Birch	14"	S 45° E	24 lks (15.84 feet)
Fir	10"	S 25° W	20 lks (13.20 feet)

PEER GROUP APPROVED

Gary L. Pisoni 12-19-97

COUNTY REPRESENTATIVE
Iron

B. Description of corner evidence found and/or method applied in restoring or reestablishing corner:
No evidence of original B.T.s found.

Section corner position located in the corner of an old fence line intersection shown to me in 1991 by John Kudwa, property owner, said fence line runs North, South and East. In 1991, I set a 5/8"x30" rebar with plastic survey cap.

I accept the fence corner as the best available evidence for restoring the Section Corner.

Corner record research on file with County Representative.

C. Description of monument for corner and accessories established to perpetuate locating the position of the corner:


Set an Iron County Remonumentation 3" dia. aluminum cap over the top of an existing rebar, said cap is flush with ground surface and stamped as follows: Iron County Remonumentation, T43N, R33W, S35, S36, S2, S1, T42N, 1997, RLS 27457 from which the following bear: (measurement taken to a nail in side of tree)

Sugar Maple	8"	North	19.33 feet
Sugar Maple	12"	N 37° E	45.47 feet
Red Maple	18"	N 80° E	10.20 feet
Steel sign post		S 48° W	0.70 feet

7-5b signed by Gary L. Pisoni

Date December 16, 1997

Surveyor's Michigan License No. 27457

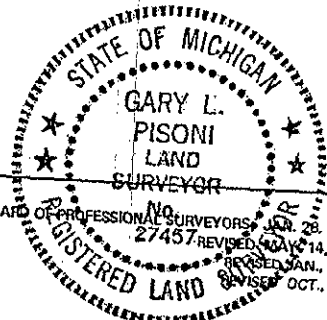

FORM APPROVED BY MICHIGAN STATE BOARD OF PROFESSIONAL SURVEYORS, JAN. 28, 1971
27457 REVISED MAY 14, 1975
REVISED JAN., 1983
REVISED OCT., 1995