

SURVEY & REMONUMENTATION

JAN 13 1998

SECTION

LAND CORNER RECORDATION CERTIFICATE
Filing Requirement of Act 74, Mich. P.A. 1970

IRON COUNTY
MICHIGAN
RECEIVED FOR RECORD

97 DEC 23 PM 1:31

L.C. Records L.P. 176

Gilbert Stiles
REGISTERED DEEDS

For corners in

Iron (County)	Located In:	Corner Code #
1. Public Land Survey	T <u>42N</u> R <u>33W</u>	<u>K-2</u>
	T _____ R _____	_____
	T _____ R _____	_____
	T _____ R _____	_____
2. Property Controlling in Section	S _____ T _____ R _____	_____
	S _____ T _____ R _____	_____
3. Miscellaneous Property in Sec.	S _____ T _____ R _____	_____
	S _____ T _____ R _____	_____

Register of Deeds Stamp & File Number

4. Lot No. _____, Recorded Plat _____
5. Private Claims _____

Quarter Corner between Sections 1 and 2

I, Gary L. Pisoni, in a field survey on December 16, 1997 do hereby state that under requirements of P.A. 74, Michigan P.A. of 1970, the corner points mentioned in lines 1 and 2 above were in conformance with regulations and rules therefore as required in the current manual of survey instructions of the United States Department of the Interior, Bureau of Land Management or by a decree of a Court of Law and/or that the corner points mentioned in lines 3, 4 and 5 above were in conformance with the rules of the Michigan Board of Land Surveyors or by a Decree of a Court of Law; established, re-established, monumented, recovered, found as expressed below:

	A	B	C	D	E	F	G	H	I	J	K	L	M
1													
2	6		5		4		3		2	●	1		
3													
4	7		8		9		10		11		12		
5													
6	18		17		16		15		14		13		
7													
8	19		20		21		22		23		24		
9													
10	30		29		28		27		26		25		
11													
12	31		32		33		34		35		36		
13													

NOTE: Not more than 2 corners, all in the same town and range, may be recorded on this certificate.

A. Description of original monument and accessories and/or subsequent restoration:
Original corner established in 1851 by Guy H. Carleton, U.S. Deputy Surveyor.
Original Corner: Wood Post
Original Bearing Trees:

Yellow Birch	12"	N 80° E	15 lks (9.90 feet)
Cedar	10"	S 60° W	25 lks (16.50 feet)

PEER GROUP APPROVED

Gary L. Pisoni 12-19-97
COUNTY REPRESENTATIVE
IRON

B. Description of corner evidence found and/or method applied in restoring or reestablishing corner:

No evidence of original B.T.s found.

Found a spike located at the intersection of a North-South fence line and the centerline of a East-West County Road.

Distance to:	NW Section Corner	N 00°23'50"W	2578.99 (meas.)	2590.50 (GLO)
	SW Section Corner	S 00°31'26"W	2668.50 (meas.)	2651.22 (GLO)


Accept the spike as the best available evidence for restoring the corner position.

Corner record research on file with County Representative.

C. Description of monument for corner and accessories established to perpetuate locating the position of the corner:

At the corner position, set a 5/8" dia. By 12" long rebar, 6" below roadbed surface with a 3" aluminum cap stamped as follows: Iron County Remonumentation, T42N, R33W, 1/4, S2, S1, 1997, RLS 27457 from which the following bear (measurements taken to nail in side of tree)

R.M.	2"x30" Al.Pipe	N 60° E	58.81 feet
Center of a 6" dia. Well casing		S 45° E	71.42 feet
Utility Pole	4489	S 61° W	58.19 feet
R.M.	2"x30" Al. Pipe	N 34° W	48.04 feet
Steel sign post		N 60° E	59.60 feet
Steel sign post		N 34° W	48.90 feet

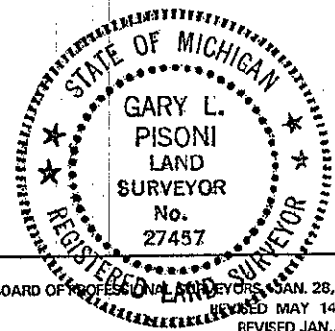

97-6b
Signed by *Gary L. Pisoni* Date December 17, 1997
Surveyor's Michigan License No. 27457