

SURVEY & REMONUMENTATION

FORM NO. 985-A



Stock No. 26273

MAR 19 1997

COMMISSION

LAND CORNER RECORDATION CERTIFICATE Filing Requirement of Act 74, Mich. P.A. 1970

For corners in

Iron
(County)

Located In:

Corner Code #

- 1. Public Land Survey T 42N R 33W
T _____ R _____
T _____ R _____
T _____ R _____
- 2. Property Controlling S _____ T _____ R _____
in Section S _____ T _____ R _____
- 3. Miscellaneous S _____ T _____ R _____
Property in Sec. S _____ T _____ R _____

K-10

IRON COUNTY
MICHIGAN
RECEIVED RECORD

95 DEC 23 AM 9:16
L.C. Records L. 7, P. 78
Gary L. Pisoni
REGISTERED LAND SURVEYOR

Register of Deeds Stamp & File Number

- 4. Lot No. _____, Recorded Plat _____
- 5. Private Claims _____

Quarter Corner between Sections 25 & 26

I, Gary L. Pisoni, in a field survey on November 20, 1996 do hereby state that under requirements of P.A. 74, Michigan P.A. of 1970, the corner points mentioned in lines 1 and 2 above were in conformance with regulations and rules therefore as required in the current manual of survey instructions of the United States Department of the Interior, Bureau of Land Management or by a decree of a Court of Law and /or that the corner points mentioned in lines 3, 4 and 5 above were in conformance with the rules of the Michigan Board of Land Surveyors or by a Decree of a Court of Law; established, re-established, monumented, recovered, found as expressed below:

NOTE: Not more than 2 corners, all in the same town and range, may be recorded on this certificate.

	A	B	C	D	E	F	G	H	I	J	K	L	M
1													
2	6			5			4			3		2	1
3													
4	7			8			9			10		11	12
5													
6	18			17			16			15		14	13
7													
8	19			20			21			22		23	24
9													
10	30			29			28			27		26	25
11													
12	31			32			33			34		35	36
13													

A. Description of original monument and accessories and/or subsequent restoration:

Original corner established by Guy H. Carleton, U.S. Deputy Surveyor in 1851.
Original corner: Wood Post
Original bearing trees:
Sugar 12" S 29° E 23 links (15.18 feet)
Hemlock 14" N 34° W 13 links (8.58 feet)

B. Description of corner evidence found and/or method applied in restoring or reestablishing corner:

No original corner evidence found.
I accept the intersection of the North-South Centerline of Buck Lake Road and an old East-West fence line as the best available evidence for restoring the Quarter corner position.


Corner Record Research on file with County Representative.

PEER GROUP APPROVED
Gary L. Pisoni 12-11-96
COUNTY REPRESENTATIVE

C. Description of monument for corner and accessories established to perpetuate locating the position of the corner:

At the corner position, I set a 5/8" by 30" long rebar pin with a 3" cast aluminum cap, 6" below road bed surface, stamped to read: Iron County Remonumentation, T42N, R33W, 1/4, S-26, S-25, 1996, RLS - 27457 from which I established the following new blazed and scribed bearing trees: (all measurements taken to a nail in side of tree)

Tamarack	11"	N 68° E	21.74 feet
Reference Monument	3/4" Aluminum Rod with cap	N 89° E	23.30 feet
White Spruce	10"	S 30° W	67.95 feet
Black Cherry	6"	S 81° W	33.68 feet
Steel Sign Post	6'	N 89° E	24.10 feet

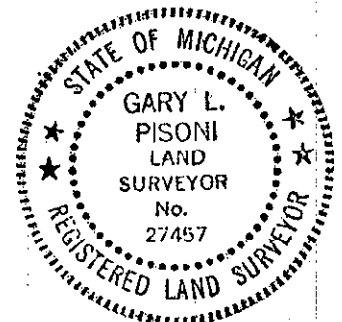

#96-56 Signed by *Gary L. Pisoni* Date 12-10-96

Surveyor's Michigan License No. 27457

L. 7 P. 78