

LAND CORNER RECORDATION CERTIFICATE
Filing Requirement of Act 74, Mich. P.A. 1970 as Amended

For corners in

Iron	Located In:	Corner Code #
<small>(County)</small>		
1. Public Land Survey	T <u>42N</u> R <u>33W</u>	<u>J13</u>
	T <u>42N</u> R <u>33W</u>	<u>K13</u>
	T _____ R _____	_____
	S _____ T _____ R _____	_____
2. Property Controlling in Section	S _____ T _____ R _____	_____
	S _____ T _____ R _____	_____
3. Miscellaneous Property in Sec.	S _____ T _____ R _____	_____
	S _____ T _____ R _____	_____

Register of Deeds Stamp & File Number

4. Lot No. _____, Recorded Plat _____
 5. Private Claims

K13 May 06 2004
 J13 Jun 17 2004

1	A	B	C	D	E	F	G	H	I	J	K	L	M
2		6		5		4		3		2		1	
3													
4		7		8		9		10		11		12	
5													
6		10		17		16		15		14		13	
7													
8		19		20		21		22		23		24	
9													
10		30		29		28		27		26		25	
11													
12		31		32		33		34		35		36	
13													

I, Stephan J. Szyszkoski, in a field survey on _____, 20____ do hereby state that under requirements of P.A. 74, Michigan P.A. of 1970, the corner points mentioned in lines 1 and 2 above were in conformance with regulations and rules therefore as required in the current manual of survey instructions of the United States Department of the Interior, Bureau of Land Management or by a decree of a Court of Law and /or that the corner points mentioned in lines 3, 4 and 5 above were in conformance with the rules of the Michigan Board of Land Surveyors or by a Decree of a Court of Law; established, re-established, monumented, recovered, found as expressed below:

NOTE: Not more than 2 corners, all in the same town and range, may be recorded on this certificate.

A. Description of original monument and accessories and/or subsequent restoration:


(J13) Quarter corner common to Sections 35 T42N-R33W and 2 T41N-R33W. Established in 1851 by Guy Carleton: West on South line Sec. 35...40.00 Set quarter Section corner. Sugar 6 S54W 31 links, Yellow Pine 18 N44W 21 links. ...80.00 Set post corner of Sections 2,3,34,35.
 (K13) Corner common to Sections 35-36 T42N-R33W and 1-2 T41N-R33W. Established in 1851 by Guy Carleton: West on south line of Section 36 ...77.00 line leaves river and set meander post...80.00 Set post corner of Sections 1,2,35, and 36. Cedar 12 N62E 28 links, Yellow Pine 16 S73W 38, Yellow Pine 20 S63E 43, Fir 6 N45W 25.

B. Description of corner evidence found and/or method applied in restoring or reestablishing corner:

(J13) The original post and accessories were not recovered. Reestablished the corner by single proportionate measurement to the original record and on the curved township line between Section corners 2641.15' East and West.
 (K13) The original post and accessories were not recovered. I reestablished the corner at the mean bearing of 4 N-S lines from corner K11 (S0 deg. 26' 14"E true bearing) and at the record distance south of K11 of 5256.90' (80.16 ch. corrected by an observed average index of -0.42'/chain). From the position thus established, reestablished section corners G13 and I13 fit very well with the original record, both in bearing and distance, and an old E-W 1/16 line fence 3/4 mile north fits quite well for being 1/4 of the distance from K11. The calls to the Brule River as written in the original notes do not fit this position very well and I did not use them to reestablish this corner.

C. Description of monument for corner and accessories established to perpetuate locating the position of the corner:

(J13) Set 1"IDx32" I.pipe with 4" alum. MDNR cap. Blazed, scribed, and set measuring nails in: 6" Poplar N36E 53.1' "1/4S NBT" 9" Poplar S23W 30.8' do 6" Poplar N15W 54.6' do 7" W.Pine N01W 83.4' do Set sq'd cedar post adjacent. Bearings are magnetic. Distances are to nail with tag.	(K13) Set 1"IDx32" I.pipe with 4" alum. MDNR cap. Blazed, scribed, and set measuring nails in: 9" Aspen N26E 2.8' "S36 NBT" 11" Aspen S44E 10.0' "S1 NBT" 7" Aspen S59W 18.3' "S2 NBT" 6" Aspen N84W 11.4' "S35 NBT" Set sq'd cedar post adjacent. Bearings are magnetic. Distances are to nail with tag.
---	---

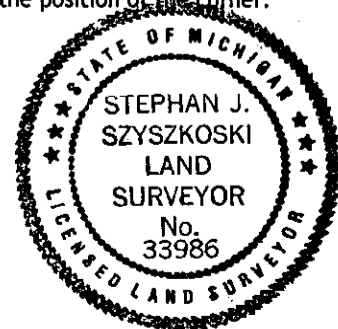

Signed by Stephan J. Szyszkoski
 Surveyor's Michigan License No. 33986

Date 6/24/04