

RECORDED

MAR 09 2000

SECTION

LAND CORNER RECORDATION CERTIFICATE
Filing Requirement of Act 74, Mich. P.A. 1970

For corners in

<u>Iron</u> (County)	Located in:	Corner Code #
1. Public Land Survey	T <u>42N</u> R <u>35W</u>	<u>M-2</u>
	T <u>42N</u> R <u>34W</u>	<u>A-2</u> ✓
	T _____ R _____	_____
	T _____ R _____	_____
2. Property Controlling in Section	S _____ T _____ R _____	_____
	S _____ T _____ R _____	_____
3. Miscellaneous Property in Sec.	S _____ T _____ R _____	_____
	S _____ T _____ R _____	_____

IRON COUNTY MICHIGAN
RECEIVED FOR RECORD

99 DEC 30 AM 10:27
L.C. Records: L. 8, P. 98
Gilbert Stetler
REGISTERED DEEDS

Register of Deeds Stamp & File Number

4. Lot No. _____, Recorded Plat _____
5. Private Claims _____

Quarter Corner to Section 1, T42N, R35W
Quarter Corner to Section 6, T42N, R34W

I, Gary L. Pisoni, in a field survey on Dec. 18, 1999 do hereby state that under requirements of P.A. 74, Michigan P.A. of 1970, the corner points mentioned in lines 1 and 2 above were in conformance with regulations and rules therefore as required in the current manual of survey instructions of the United States Department of the Interior, Bureau of Land Management or by a decree of a Court of Law and /or that the corner points mentioned in lines 3, 4 and 5 above were in conformance with the rules of the Michigan Board of Land Surveyors or by a Decree of a Court of Law; established, re-established, monumented, recovered, found as expressed below:

NOTE: Not more than 2 corners, all in the same town and range, may be recorded on this certificate.

1	A	B	C	D	E	F	G	H	I	J	K	L	M
2	6		5		4		3		2		1		
3													
4	7		8		9		10		11		12		
5													
6	18		17		16		15		14		13		
7													
8	19		20		21		22		23		24		
9													
10	30		29		28		27		26		25		
11													
12	31		32		33		34		35		36		
13													

A. Description of original monument and accessories and/or subsequent restoration:

Original corner established in 1846 by William A. Burt, U.S. Deputy Surveyor.
Original Corner; Cedar Wood Post.
Original Bearing Trees:
Fir 7" S 79° E 10 lks (6.60 feet)
Cedar 18" N 70° W 8 lks (5.28 feet)

PEER GROUP APPROVED
Gary L. Pisoni 12-28-99
COUNTY REPRESENTATIVE

B. Description of corner evidence found and/or method applied in restoring or reestablishing corner:

No evidence of original B.T.s found.


Found the Southeast corner of the Assessor's Plat of Old Caspian marked by a Plat monument, existing monument has been damaged due to sewer line construction. Monument is lying at an angle to the Southeast. Reset the Plat monument from existing Plat monuments located in Lots 15 - 47. Monument is located in the South lane of an alley. I accept the above described monument as the best available evidence for restoring the corner position.

Corner record research on file with County Representative.

C. Description of monument for corner and accessories established to perpetuate locating the position of the corner:

At the corner position, set a 5/8" diameter by 30" long rebar, 6" below roadbed surface with a 3" diameter aluminum cap stamped as follows: Iron County Remonumentation, T42N, R35W, R34W, 1/4, S-1, S-6, 1999, RLS 27457 from which I established the following new blazed and scribed bearing tree and corner references: (All measurements taken to a nail in side of tree)

Rebar	5/8" x 30" rebar	N 68° E	68.40 feet
Popple	6"	S 70° E	74.18 feet
Utility Pole		S 40° W	13.30 feet
Spruce	10"	N 26° W	89.46 feet (no blazes on tree)
Steel sign post		South	9.90 feet

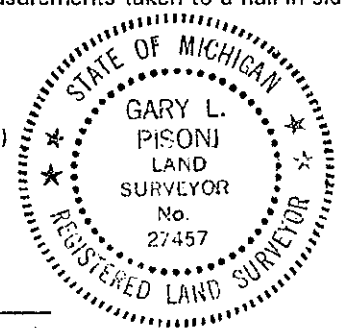

99-98
Signed by Gary L. Pisoni Date 12-28-99
Surveyor's Michigan License No. 27457