

MAR 09 2000

SECTION

LAND CORNER RECORDATION CERTIFICATE
Filing Requirement of Act 74, Mich. P.A. 1970

For corners in

Iron <small>(County)</small>	Located In:	Corner Code #
1. Public Land Survey	T <u>42N</u> R <u>35W</u>	<u>M-5</u>
	T <u>42N</u> R <u>34W</u>	<u>A-5</u> ✓
	T _____ R _____	_____
	T _____ R _____	_____
2. Property Controlling in Section	S _____ T _____ R _____	_____
	S _____ T _____ R _____	_____
3. Miscellaneous Property in Sec.	S _____ T _____ R _____	_____
	S _____ T _____ R _____	_____

IRON COUNTY
MICHIGAN
RECEIVED FOR RECORD

99 DEC 30 AM 10:28

L.C. Records: L, S, P, 106

Gary L. Pisoni


REGISTERED LAND SURVEYOR

Register of Deeds Stamp & File Number

4. Lot No. _____, Recorded Plat _____
5. Private Claims _____

Section corner to Sections 12 and 13, T42N, R35W
Section corner to Section 7 and 18, T42N, R34W

I, Gary L. Pisoni, in a field survey on Nov. 11, 1999 do hereby state that under requirements of P.A. 74, Michigan P.A. of 1970, the corner points mentioned in lines 1 and 2 above were in conformance with regulations and rules therefore as required in the current manual of survey instructions of the United States Department of the Interior, Bureau of Land Management or by a decree of a Court of Law and /or that the corner points mentioned in lines 3, 4 and 5 above were in conformance with the rules of the Michigan Board of Land Surveyors or by a Decree of a Court of Law; established, re-established, monumented, recovered, found as expressed below:

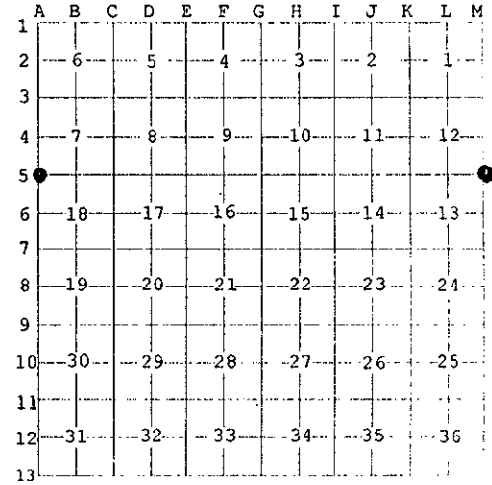

NOTE: Not more than 2 corners, all in the same town and range, may be recorded on this certificate.

A. Description of original monument and accessories and/or subsequent restoration:

Original corner established in 1846 by William A. Burt, U.S. Deputy Surveyor.
Original Corner; Sugar Wood Post
Original Bearing Trees:
Sugar 16" S 34° E 30 lks (19.80 feet)
Sugar 12" N 21° W 7 lks (4.62 feet)

PEER GROUP APPROVED
Iron Aug 18 12-21-99
COUNTY REPRESENTATIVE

On October 13, 1851, Guy H. Carleton, U.S. Deputy Surveyor made the following two (2) bearing trees:
Sugar 10" N 75° E 37 lks (24.42 feet)
Sugar 12" S 45° W 45 lks (29.70 feet)

B. Description of corner evidence found and/or method applied in restoring or reestablishing corner:

No evidence of original B.T.s found.
At the corner position, found a 1" by 38" long iron bar with T at bottom of iron bar. Iron bar is consistent with GLO distances North and South along the Range line. I accept the iron bar as the best available evidence for restoring the corner position.
Corner record research on file with County Representative.

C. Description of monument for corner and accessories established to perpetuate locating the position of the corner:

At the corner position, I replaced the iron bar with a 2" diameter by 30" long split base aluminum pipe monument, with a 3" dia. aluminum cap stamped as follows: Iron County Remonumentation, T42N, R35W, R34W, S-12, S-13, S-7, S-18, 1999, RLS 27457 from which I established the following new blazed and scribed bearing trees:(All measurements taken to a nail in side of tree)

Sugar Maple (dbl)	8"	S 46° W	31.35 feet
Sugar Maple	8"	N 38° W	19.22 feet
Sugar Maple	9"	N 27° E	20.48 feet
Sugar Maple	9"	S 57° E	3.59 feet
Steel sign post		North	0.66 feet

99-106
Signed by *Gary L. Pisoni* Date 12-28-99
Surveyor's Michigan License No. 27457

