

MAR 09 2000

SECTION

LAND CORNER RECORDATION CERTIFICATE
Filing Requirement of Act 74, Mich. P.A. 1970

For corners in

_____ Iron _____ (County)	Located In:	Corner Code #
1. Public Land Survey	T <u>42N</u> R <u>35W</u>	<u>M-10</u>
	T <u>42N</u> R <u>34W</u>	<u>A-10</u> ✓
	T _____ R _____	_____
	T _____ R _____	_____
2. Property Controlling in Section	S _____ T _____ R _____	_____
	S _____ T _____ R _____	_____
3. Miscellaneous	S _____ T _____ R _____	_____
Property in Sec.	S _____ T _____ R _____	_____

IRON COUNTY
MICHIGAN
RECEIVED FOR RECORD
99 DEC 30 AM 10:29
L.C. Records: 1.8, P. 111
Gary L. Pisoni
REGISTERED DEEDS

Register of Deeds Stamp & File Number

4. Lot No. _____, Recorded Plat _____
5. Private Claims _____

Quarter Corner to Section 25, T42N, R35W
Quarter Corner to Section 30, T42N, R34W

I, Gary L. Pisoni, in a field survey on Nov. 1, 1999 do hereby state that under requirements of P.A. 74, Michigan P.A. of 1970, the corner points mentioned in lines 1 and 2 above were in conformance with regulations and rules therefore as required in the current manual of survey instructions of the United States Department of the Interior, Bureau of Land Management or by a decree of a Court of Law and /or that the corner points mentioned in lines 3, 4 and 5 above were in conformance with the rules of the Michigan Board of Land Surveyors or by a Decree of a Court of Law; established, re-established, monumented, recovered, found as expressed below:

1	A	B	C	D	E	F	G	H	I	J	K	L	M
2		6		5		4		3		2		1	
3													
4		7		8		9		10		11		12	
5													
6		18		17		16		15		14		13	
7													
8		19		20		21		22		23		24	
9													
10		30		29		28		27		26		25	
11													
12		31		32		33		34		35		36	
13													

NOTE: Not more than 2 corners, all in the same town and range, may be recorded on this certificate.

A. Description of original monument and accessories and/or subsequent restoration:

Original corner established in 1846 by William A. Burt, U.S. Deputy Surveyor.
Original Corner; Sugar Wood Post
Original Bearing Trees:
Elm 10" N 69° E 17 lks (11.22 feet)
Sugar 10" S 45° W 10 lks (6.60 feet)

PEER GROUP APPROVED
Iron County Rep. 12-21-99
COUNTY REPRESENTATIVE

B. Description of corner evidence found and/or method applied in restoring or reestablishing corner:


Restored the corner position at record bearing and distance from the remains of the Elm bearing tree stump and a large depression for the Sugar Maple stump.

Corner record research on file with County Representative.

C. Description of monument for corner and accessories established to perpetuate locating the position of the corner:

At the corner position, set a 5/8" diameter by 30" long rebar with a 3" diameter aluminum cap stamped as follows: Iron County Remonumentation, T42N, R35W, R34W, 1/4, S-25, S-30, 1999, RLS 27457 from which I established the following new blazed and scribed bearing trees: (All measurements taken to a nail in side of tree)

Snow Fence Stake		S 01° E	72 feet
Sugar Maple	10"	N 66° W	50.64 feet
Sugar Maple	7"	N 39° E	19.12 feet
Ironwood (dbl)	7"	S 53° E	26.78 feet
Sugar Maple	6"	S 34° W	3.61 feet
Steel sign post		S 04° W	0.7 feet

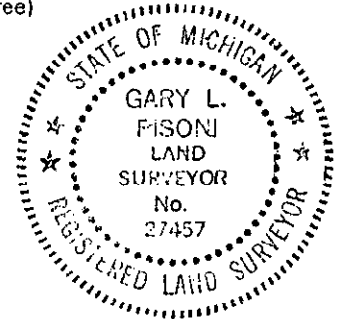

99-111

Signed by *Gary L. Pisoni* Date 12-28-99

Surveyor's Michigan License No. 27457