

MAR 09 2000

SECTION

LAND CORNER RECORDATION CERTIFICATE
Filing Requirement of Act 74, Mich. P.A. 1970

For corners in

Form with fields for County (Iron), Located In (T 42N R 35W, T 42N R 34W), and Corner Code # (M-11, A-11).

IRON COUNTY MICHIGAN RECEIVED FOR RECORD

99 DEC 30 AM 10:29

L.C. Records: L.S. P. 112

Handwritten signature and title of County Representative.

Register of Deeds Stamp & File Number

4. Lot No. , Recorded Plat
5. Private Claims

Section Corner to Sections 25 and 36, T42N, R35W
Section Corner to Sections 30 and 31, T42N, R34W

I, Gary L. Pisoni, in a field survey on Nov. 1, 1999 do hereby state that under requirements of P.A. 74, Michigan P.A. of 1970, the corner points mentioned in lines 1 and 2 above were in conformance with regulations and rules therefore as required in the current manual of survey instructions of the United States Department of the Interior, Bureau of Land Management or by a decree of a Court of Law and /or that the corner points mentioned in lines 3, 4 and 5 above were in conformance with the rules of the Michigan Board of Land Surveyors or by a Decree of a Court of Law; established, re-established, monumented, recovered, found as expressed below:

Grid table with columns A-M and rows 1-13, containing numerical values for section corners.

NOTE: Not more than 2 corners, all in the same town and range, may be recorded on this certificate.

A. Description of original monument and accessories and/or subsequent restoration:

Original corner established in 1846 by William A. Burt, U.S. Deputy Surveyor. Original Corner; Fir Wood Post
Original Bearing Trees:
Elm 18" S 27° E 19 lks (12.54 feet)
White Pine 30" N 21° W 31 lks (20.46 feet)
On October 14, 1851, Guy H. Carleton, U.S. Deputy Surveyor made the following new bearing tree:
Spruce 10" N 47° E 47 lks (31.02 feet)

PEER GROUP APPROVED
Iron County Representative
12-21-99


B. Description of corner evidence found and/or method applied in restoring or reestablishing corner:

Restored the corner position at record bearing and distance from the White Pine bearing tree stump which is now 4 + feet in diameter located on the North edge of a farm field. Corner position is approximately 12 feet into the farm field.

Corner record research on file with County Representative.

C. Description of monument for corner and accessories established to perpetuate locating the position of the corner:

At the corner position, set a 2" diameter by 30" long split base aluminum pipe monument, with a 3" dia. aluminum cap stamped as follows: Iron County Remonumentation, T42N, R35W, R34W, S-25, S-36, S-30, S-31, 1999, RLS 27457 from which I established the following new blazed and scribed bearing trees:(All measurements taken to a nail in side of tree)
Black Cherry 6" N 40° W 28.76 feet
Maple 8" N 04° W 58.67 feet
Maple 7" N 34° E 99.68 feet
Balsam 7" S 80° E 57.53 feet
Steel sign post North 1.07 feet

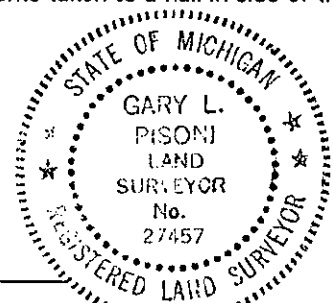

99-112
Signed by Gary L. Pisoni Date 12-28-99
Surveyor's Michigan License No. 27457