

MAR 09 2000

SECTION

LAND CORNER RECORDATION CERTIFICATE
Filing Requirement of Act 74, Mich. P.A. 1970

For corners in

	Located In:	Corner Code #
Iron <small>(County)</small>		
1. Public Land Survey	T <u>42N</u> R <u>34W</u>	<u>C-2</u>
	T _____ R _____	_____
	T _____ R _____	_____
	T _____ R _____	_____
2. Property Controlling in Section	S _____ T _____ R _____	_____
	S _____ T _____ R _____	_____
3. Miscellaneous Property in Sec.	S _____ T _____ R _____	_____
	S _____ T _____ R _____	_____

IRON COUNTY
MICHIGAN
RECEIVED FOR RECORD

99 DEC 30 AM 10:27
L.C. Records: L.S., P. 99
Gailen Stebbins
REGISTER OF DEEDS


Register of Deeds Stamp & File Number

4. Lot No. _____, Recorded Plat _____
5. Private Claims _____

Quarter Corner to Sections 6 and 5, T42N, R34W

I, Gary L. Pisoni, in a field survey on Nov. 6, 1999 do hereby state that under requirements of P.A. 74, Michigan P.A. of 1970, the corner points mentioned in lines 1 and 2 above were in conformance with regulations and rules therefore as required in the current manual of survey instructions of the United States Department of the Interior, Bureau of Land Management or by a decree of a Court of Law and /or that the corner points mentioned in lines 3, 4 and 5 above were in conformance with the rules of the Michigan Board of Land Surveyors or by a Decree of a Court of Law; established, re-established, monumented, recovered, found as expressed below:

NOTE: Not more than 2 corners, all in the same town and range, may be recorded on this certificate.

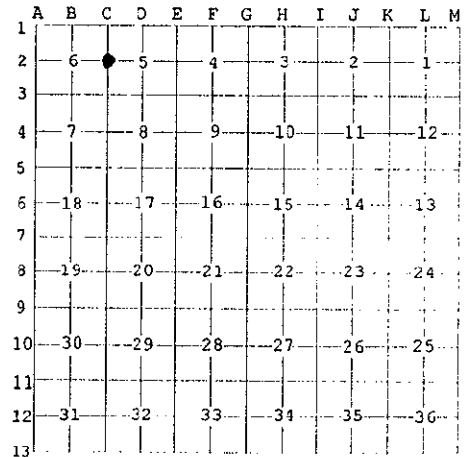

A. Description of original monument and accessories and/or subsequent restoration:

Original corner established on October 12, 1851 by Guy H. Carleton, U.S. Deputy Surveyor.
Original Corner; Wood Post
Original Bearing Trees:
Fir 10" N 65° E 75 lks (49.50 feet)
Sugar 14" S 25° W 42 lks (27.72 feet)

PEER GROUP APPROVED
Iron County Surveyors 12-21-99
COUNTY REPRESENTATIVE

B. Description of corner evidence found and/or method applied in restoring or reestablishing corner:

No evidence of original B.T.s found.

At the corner position, found a squared iron bar encased in a 6" concrete cylinder located at the corner of a rock fenceline running East and South. At the South 1/16 corner between Sections 5 and 6 there is a fence line running East and West, said 1/16 corner is midway between the Southwest corner of Section 5 and the existing iron bar in concrete which is marking the quarter corner position. Fencelines were established in the late 1800's. I accept the iron bar as the best available evidence for restoring the corner position.

Corner record research on file with County Representative.


C. Description of monument for corner and accessories established to perpetuate locating the position of the corner:

Set one (1) reference monument, being a 5/8" diameter by 30" long rebar pin with a 3" diameter aluminum cap stamped as follows: Iron County Remonumentation, T42N, R34W, R.M. 1/4, S-6, S-5, N 46° W, 8.82 feet, 1999, RLS 27457 from which I established the following new blazed and scribed bearing trees: (All measurements taken to a nail in side of tree)

Sugar Maple	11"	N 57° E	55.63 feet
R.M.	5/8" x 30"	S 46° E	8.82 feet
Yellow Birch (clump)	8"	S 42° W	56.94 feet
Basswood (clump)	8"	N 42° W	32.57 feet
Steel sign post		North	0.5 feet

99-99
Signed by Gary L. Pisoni Date 12-28-99

Surveyor's Michigan License No. 27457

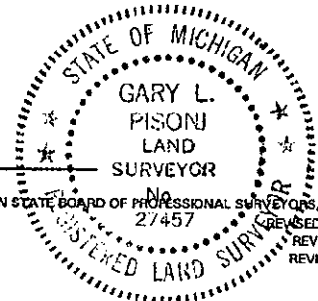

FORM APPROVED BY MICHIGAN STATE BOARD OF PROFESSIONAL SURVEYORS, JAN. 28, 1971
REVISED MAY 14, 1975
REVISED JAN., 1983
REVISED OCT., 1995

31 32
6 5
N00° 17' 34" W 2647.38'
1/4
6 N00° 42' 28" E 2577.50'
7 8