

SURVEY & REMONUMENTATION

JAN 19 1999

SECTION

LAND CORNER RECORDATION CERTIFICATE
Filing Requirement of Act 74, Mich. P.A. 1970

For corners in

| <u>Iron</u> (County) | Located In: | Corner Code # |
|------------------------------------|---------------------------|---------------|
| 1. Public Land Survey | T <u>42N</u> R <u>34W</u> | <u>C-3</u> |
| | T _____ R _____ | _____ |
| | T _____ R _____ | _____ |
| | T _____ R _____ | _____ |
| 2. Property Controlling in Section | S _____ T _____ R _____ | _____ |
| | S _____ T _____ R _____ | _____ |
| 3. Miscellaneous Property in Sec. | S _____ T _____ R _____ | _____ |
| | S _____ T _____ R _____ | _____ |

IRON COUNTY MICHIGAN
 RECEIVED FOR RECORD

98 DEC 28 AM 11:27

L.C. Records: L. 7, P. 327

Gary L. Pisoni
 REGISTERED LAND SURVEYOR

Register of Deeds Stamp & File Number

4. Lot No. _____, Recorded Plat _____
 5. Private Claims _____

Section Corner Sections 5, 6, 7 and 8, T42N, R34W

I, Gary L. Pisoni, in a field survey on Dec. 9, 1998, do hereby state that under requirements of P.A. 74, Michigan P.A. of 1970, the corner points mentioned in lines 1 and 2 above were in conformance with regulations and rules therefore as required in the current manual of survey instructions of the United States Department of the Interior, Bureau of Land Management or by a decree of a Court of Law and /or that the corner points mentioned in lines 3, 4 and 5 above were in conformance with the rules of the Michigan Board of Land Surveyors or by a Decree of a Court of Law; established, re-established, monumented, recovered, found as expressed below:

NOTE: Not more than 2 corners, all in the same town and range, may be recorded on this certificate.

| | | | | | | | | | | | | |
|----|----|---|----|---|----|---|----|---|----|---|----|---|
| A | B | C | D | E | F | G | H | I | J | K | L | M |
| 1 | | | | | | | | | | | | |
| 2 | 6 | | 5 | | 4 | | 3 | | 2 | | 1 | |
| 3 | | ● | | | | | | | | | | |
| 4 | 7 | | 8 | | 9 | | 10 | | 11 | | 12 | |
| 5 | | | | | | | | | | | | |
| 6 | 18 | | 17 | | 16 | | 15 | | 14 | | 13 | |
| 7 | | | | | | | | | | | | |
| 8 | 19 | | 20 | | 21 | | 22 | | 23 | | 24 | |
| 9 | | | | | | | | | | | | |
| 10 | 30 | | 29 | | 28 | | 27 | | 26 | | 25 | |
| 11 | | | | | | | | | | | | |
| 12 | 31 | | 32 | | 33 | | 34 | | 35 | | 36 | |
| 13 | | | | | | | | | | | | |

A. Description of original monument and accessories and/or subsequent restoration:

Original corner established on October 12, 1851 by Guy H. Carleton, U.S. Deputy Surveyor.
 Original Corner; Wood Post
 Original Bearing Trees:

| | | | |
|-------|-----|---------|-----------------------|
| Sugar | 12" | N 80° W | 32 links (21.12 feet) |
| Sugar | 10" | S 40° E | 45 links (29.70 feet) |

In 1977, Ewart C. Muller RLS found an iron pin marking the SE corner of the Plat of Gaastra which is also the Section corner between Sections 5, 6, 7, 8, recorded in L.C. Certificate Liber 1, Page 452 on 3/17/77.

In 1980, Gary L. Pisoni RLS found the Section corner located in the centerline of County Road 424 and in the centerline of North 5th Street which runs North. Section corner was a plat monument and being the Southeast corner of the Plat of Gaastra, monument was located 4" below asphalt surface. In 1994, Iron County rebuilt County Road 424 and destroyed the plat monument. I referenced the monument prior to construction and after repavement of County Road 424, I reset the Section corner with a P.K. nail.

PEER GROUP APPROVED

Iron H. Pisoni 12-18-98
 COUNTY REPRESENTATIVE

B. Description of corner evidence found and/or method applied in restoring or reestablishing corner:

No evidence of original B.T.s found. Found the P.K. nail as described above. I accept the P.K. nail as the best available evidence for restoring the corner position.

Corner record research on file with County Representative.

C. Description of monument for corner and accessories established to perpetuate locating the position of the corner:


From the above described corner position, I set a reference monument, being a 5/8" diameter by 30" long rebar, with a 3" aluminum cap stamped as follows: Iron County Remonumentation, T42N, R34W, R.M., S-5, S-6, S-7, S-8, North, 30.34', 1998, RLS 27457, from which I established the following new bearing trees: (All measurements taken to a nail in side of tree, no B.T. signs or blazing on trees)

| | | | |
|------------------------------|------------------|--------|------------|
| Utility Pole w/ street light | | N 39°W | 32.00 feet |
| Sugar Maple | 22" | N 45°E | 57.84 feet |
| Utility Guide Pole | | S 51°E | 44.21 feet |
| Utility Pole w/transformer | | S 47°E | 39.38 feet |
| Red Maple | 17" | S 15°W | 53.30 feet |
| R.M. | 5/8" x 30" rebar | South | 30.34 feet |
| Steel sign post | | South | 30.85 feet |

98-156
 Signed by Gary L. Pisoni

Date 12-21-98

Surveyor's Michigan License No. 27457

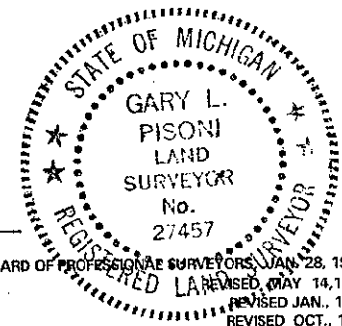

L. 7 P 327