

MAR 09 2000

SECTION

LAND CORNER RECORDATION CERTIFICATE
Filing Requirement of Act 74, Mich. P.A. 1970

For corners in

<u>Iron</u> (County)	Located In:	Corner Code #
1. Public Land Survey	T <u>42N</u> R <u>34W</u>	<u>E-2</u>
	T _____ R _____	_____
	T _____ R _____	_____
	T _____ R _____	_____
2. Property Controlling in Section	S _____ T _____ R _____	_____
	S _____ T _____ R _____	_____
3. Miscellaneous Property in Sec.	S _____ T _____ R _____	_____
	S _____ T _____ R _____	_____

IRON COUNTY MICHIGAN
RECEIVED FOR RECORD

99 DEC 30 AM 10:27
L.C. Records: L. 8, P. 100
Gibson

Register of Deeds Stamp & File Number

4. Lot No. _____, Recorded Plat _____
5. Private Claims _____

Quarter Corner to Sections 5 and 4, T42N, R34W

I, Gary L. Pisoni, in a field survey on Dec. 18, 1999 do hereby state that under requirements of P.A. 74, Michigan P.A. of 1970, the corner points mentioned in lines 1 and 2 above were in conformance with regulations and rules therefore as required in the current manual of survey instructions of the United States Department of the Interior, Bureau of Land Management or by a decree of a Court of Law and /or that the corner points mentioned in lines 3, 4 and 5 above were in conformance with the rules of the Michigan Board of Land Surveyors or by a Decree of a Court of Law; established, re-established, monumented, recovered, found as expressed below:

NOTE: Not more than 2 corners, all in the same town and range, may be recorded on this certificate.

	A	B	C	D	E	F	G	H	I	J	K	L	M
1													
2	6			5	•	4		3		2			1
3													
4	7			8		9		10		11			12
5													
6	18			17		16		15		14			13
7													
8	19			20		21		22		23			24
9													
10	30			29		28		27		26			25
11													
12	31			32		33		34		35			36
13													

A. Description of original monument and accessories and/or subsequent restoration:

Original corner established on October 11, 1851 by Guy H. Carleton, U.S. Deputy Surveyor.

Original Corner; Wood Post

Original Bearing Trees:

Fir	9"	N 30° E	11 lks (7.26 feet)
Fir	9"	S 45° W	30 lks (19.80 feet)

PEER GROUP APPROVED
Don Harold Pearson 12-21-99
COUNTY REPRESENTATIVE

B. Description of corner evidence found and/or method applied in restoring or reestablishing corner:


No evidence of original B.T.s found. Found an iron pin located in the centerline of a North-South county road and in line with the centerline of a woods road running East and a rock fenceline running West. I accept the iron pin as the best available evidence for restoring the corner position.

Corner record research on file with County Representative.

C. Description of monument for corner and accessories established to perpetuate locating the position of the corner:

At the corner position, I replaced the existing iron pin and set a 5/8" diameter by 30" long rebar, 8" below roadbed surface, with a 3" diameter aluminum cap stamped as follows: Iron County Remonumentation, T42N, R34W, 1/4, S-5, S-4, 1999, RLS 27457 from which I established the following new blazed and scribed bearing trees: (All measurements taken to a nail in side of tree)

R.M.	5/8" x 30" rebar	N 24° E	64.90 feet
Sugar Maple	6"	S 70° E	49.98 feet
Basswood	9"	S 76° W	76.13 feet
Rebar	5/8" x 30"	N 29° W	64.82 feet
Rebar	5/8" x 30"	West	20.43 feet
Steel sign post		West	21.05 feet

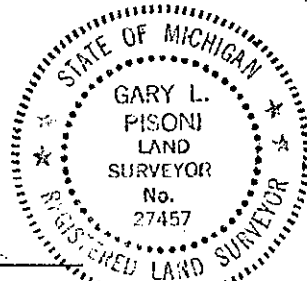

99-100
Signed by Gary L. Pisoni Date 12-28-99

Surveyor's Michigan License No. 27457

FORM APPROVED BY MICHIGAN STATE BOARD OF PROFESSIONAL SURVEYORS, JAN. 28, 1971
REVISED MAY 14, 1975
REVISED JAN., 1983
REVISED OCT., 1995