

MAR 09 2000

SECTION

LAND CORNER RECORDATION CERTIFICATE
Filing Requirement of Act 74, Mich. P.A. 1970

For corners in

<u>Iron</u> (County)	Located In:	Corner Code #	
1. Public Land Survey	T <u>42N</u> R <u>34W</u>	<u>F-4</u>	
	T _____ R _____	_____	
	T _____ R _____	_____	
	T _____ R _____	_____	
2. Property Controlling in Section	S _____ T _____ R _____	_____	
	S _____ T _____ R _____	_____	
3. Miscellaneous Property in Sec.	S _____ T _____ R _____	_____	
	S _____ T _____ R _____	_____	

IRON COUNTY
MICHIGAN
RECEIVED FOR RECORD

99 DEC 30 AM 10:28
L.C. Records: L.8, P.105
Gary L. Pisoni
REGISTERED LAND SURVEYOR


Register of Deeds Stamp & File Number

4. Lot No. _____, Recorded Plat _____
5. Private Claims _____

Quarter Corner to Section 8 and 9, T42N, R34W

I, Gary L. Pisoni, in a field survey on April 24, 1999 do hereby state that under requirements of P.A. 74, Michigan P.A. of 1970, the corner points mentioned in lines 1 and 2 above were in conformance with regulations and rules therefore as required in the current manual of survey instructions of the United States Department of the Interior, Bureau of Land Management or by a decree of a Court of Law and/or that the corner points mentioned in lines 3, 4 and 5 above were in conformance with the rules of the Michigan Board of Land Surveyors or by a Decree of a Court of Law; established, re-established, monumented, recovered, found as expressed below:

NOTE: Not more than 2 corners, all in the same town and range, may be recorded on this certificate.

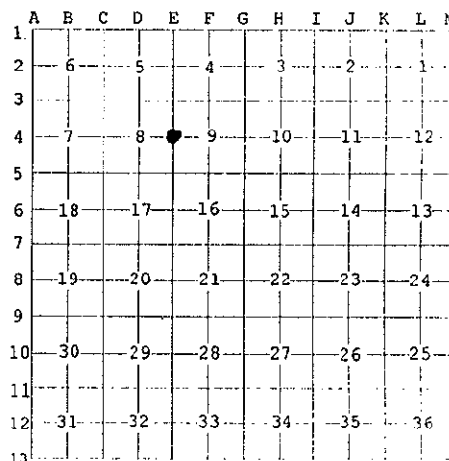

A. Description of original monument and accessories and/or subsequent restoration:

Original corner established on October 11, 1851 by Guy H. Carleton, U.S. Deputy Surveyor.
Original Corner; Wood Post
Original Bearing Trees:

Lynn	10"	N 60° W	30 lks (19.80 feet)
Ironwood	9"	S 80° E	18 lks (11.88 feet)

PEER GROUP APPROVED
Gary L. Pisoni 12-21-99
COUNTY REPRESENTATIVE

B. Description of corner evidence found and/or method applied in restoring or reestablishing corner:

No evidence of original B.T.s found.

Found a 3/4" diameter iron bar, 24" long located at the corner position. Iron bar was set by Donald D. Lappala, RLS, in the late 1970's. Iron bar has been used for many surveys in the surrounding area for many years. Iron bar is located 21 feet North of the centerline of Groulx Lane which runs East.


I accept the iron bar as the best available evidence for restoring the corner position.

Corner record research on file with County Representative.

C. Description of monument for corner and accessories established to perpetuate locating the position of the corner:

At the corner position replaced iron bar and set a 3/4" diameter aluminum rod monument, 3 feet long and 2" above ground surface with a 3" diameter aluminum cap stamped as follows: Iron County Remonumentation, T42N, R34W, 1/4, S-8, S-9, 1999, RLS 27457 from which I established the following new blazed and scribed bearing trees: (All measurements taken to a nail in side of tree)

Rebar	5/8" x 30"	North	11.98 feet
Basswood	14"	N 83° E	27.33 feet
Red Maple	8"	S 42° E	69.10 feet
Sugar Maple	6"	S 09° E	58.54 feet
Utility Pole	#M-179 #30	S 41° W	57.64 feet
Steel sign post		North	0.65 feet

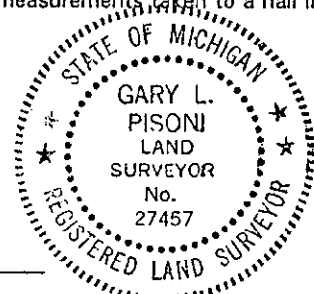

99-105
Signed by Gary L. Pisoni Date 12-28-99

Surveyor's Michigan License No. 27457