

1993

COMMISSION

LAND CORNER RECORDATION CERTIFICATE
Filing Requirement of Act 74, Mich. P.A. 1970

IRON COUNTY MICHIGAN RECEIVED FOR RECORD

93 DEC 29 PM 2: 21
L.C. RECORDS L.C. P. 297

Gilbert Stiehl
REGISTER OF DEEDS

For corners in


Iron (County)	Located In:	Corner Code #
1. Public Land Survey	T 42N R 34W	L-5
	T R	
	T R	
	T R	
2. Property Controlling in Section	S T R	
	S T R	
3. Miscellaneous Property in Sec.	S T R	
	S T R	

Register of Deeds Stamp & File Number

- 4. Lot No. _____, Recorded Plat _____
- 5. Private Claims _____

Quarter Corner 12-13 T42N R34W

I, Gary L. Pisoni, in a field survey on December 20, 19 93
do hereby certify that under requirements of P.A. 74, Michigan P.A. of 1970, the corner points mentioned in lines 1 and 2 above were in conformance with regulations and rules therefore as required in the current manual of survey instructions of the United States Department of the Interior, Bureau of Land Management or by a decree of a Court of Law and/or that the corner points mentioned in lines 3, 4 and 5 above were in conformance with the rules of the Michigan Board of Land Surveyors or by a Decree of a Court of Law; established, re-established, monumented, ~~re-monumented~~, recovered, found as expressed below:

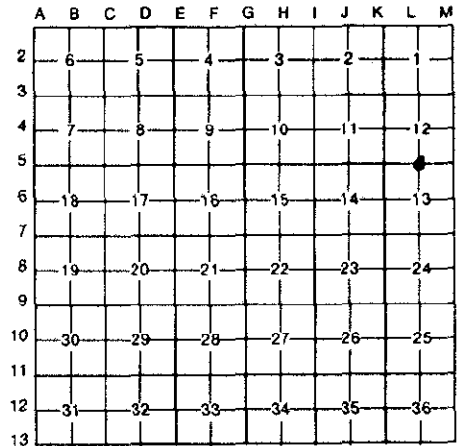

NOTE: Not more than 4 corners, all in the same town and range, may be recorded on this certificate.

A. Description of original monument and accessories and/or subsequent restoration:

Original corner established by Guy H. Carleton, U.S. Deputy Surveyor in 1851.

Original corner: Wood Post

Original bearing trees:

Cedar	6"	N 40° E	7 links (4.62 feet)
Cedar	8"	S 05° W	17 links (11.22 feet)

B. Description of corner evidence found and/or method applied in restoring or reestablishing corner:


No evidence of original corner or bearing tree remains. Corner position found marked by a 1" diameter iron pipe inside a 1 1/2" iron pipe. Removed 1" iron pipe and replaced it with a 7 feet aluminum rod monument as described below. Layed 1" iron pipe next to monument. Corner position has been used and accepted locally, for many years. Monument is 4" above ground surface.

This corner is accepted as the best available evidence of the position of the original corner.

C. Description of monument for corner and accessories established to perpetuate locating the position of the corner:

At the corner position, I set a 3/4" outside diameter by 7 feet long aluminum rod monument with a 3" cast aluminum cap, stamped to read: Iron County Remonumentation, T42N, R34W, 1/4, S-12, S-13, 1993, RLS 27457 from which I established the following new blazed and scribed bearing trees: (all measurements taken to a nail in side of tree)

Cedar (existing)	8"	N 24° E	6.38 feet
Cedar (existing)	6"	S 75° E	13.89 feet
Cedar (new)	9"	S 15° W	15.83 feet
Tamarack (existing)	8"	N 72° W	7.75 feet
Steel Sign Post		North	0.58 feet

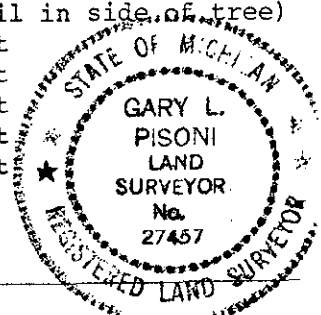

Signed by Gary L. Pisoni

Date 12-28-93

Surveyor's Michigan License No. 27457