

MAR 09 2000

SECTION

LAND CORNER RECORDATION CERTIFICATE
Filing Requirement of Act 74, Mich. P.A. 1970

For corners in

<u>Iron</u> (County)	Located In:	Corner Code #
1. Public Land Survey	T <u>42N</u> R <u>34W</u>	<u>M-8</u> ✓
	T <u>42N</u> R <u>33W</u>	<u>A-8</u>
	T _____ R _____	_____
	T _____ R _____	_____
2. Property Controlling in Section	S _____ T _____ R _____	_____
	S _____ T _____ R _____	_____
3. Miscellaneous Property in Sec.	S _____ T _____ R _____	_____
	S _____ T _____ R _____	_____

IRON COUNTY MICHIGAN RECEIVED FOR RECORD

99 DEC 30 AM 10:17

L.C. Records: L. 8, P. 47

Richard Stebbins
REGISTERED LAND SURVEYOR

Register of Deeds Stamp & File Number

- 4. Lot No. _____, Recorded Plat _____
- 5. Private Claims _____

Quarter Corner to Section 24, T42N, R34W
Quarter Corner to Section 19, T42N, R33W

I, Gary L. Pisoni, in a field survey on July 30, 1999 do hereby state that under requirements of P.A. 74, Michigan P.A. of 1970, the corner points mentioned in lines 1 and 2 above were in conformance with regulations and rules therefore as required in the current manual of survey instructions of the United States Department of the Interior, Bureau of Land Management or by a decree of a Court of Law and /or that the corner points mentioned in lines 3, 4 and 5 above were in conformance with the rules of the Michigan Board of Land Surveyors or by a Decree of a Court of Law; established, re-established, monumented, recovered, found as expressed below:

NOTE: Not more than 2 corners, all in the same town and range, may be recorded on this certificate.

	A	B	C	D	E	F	G	H	I	J	K	L	M
1													
2		6		5		4		3		2		1	
3													
4		7		8		9		10		11		12	
5													
6		18		17		16		15		14		13	
7													
8		19		20		21		22		23		24	
9													
10		30		29		28		27		26		25	
11													
12		31		32		33		34		35		36	
13													

A. Description of original monument and accessories and/or subsequent restoration:

Original corner established on Sept. 8, 1846 by Austin Burt, U.S. Deputy Surveyor.
Original Corner; Ironwood Post
Original Bearing Trees:
Elm 6" S 44° W 21 lks (13.86 feet)
Sugar 16" N 65° E 15 lks (9.90 feet)

PEER GROUP APPROVED
Iron Gary L. Pisoni 12-21-97
COUNTY REPRESENTATIVE

B. Description of corner evidence found and/or method applied in restoring or reestablishing corner:

No evidence of original B.T.s found.


Found iron pin located in the centerline of a North/South county road, buried below roadbed surface and in line with an old rock fence line running East and West. Distances along the range line are consistent with GLO distances. I accept the iron pin as the best available evidence for restoring the corner position. Set railroad spike in blacktop surface over top of iron pin.

Corner record research on file with County Representative.

C. Description of monument for corner and accessories established to perpetuate locating the position of the corner:

Set two (2) reference monuments being a 5/8" diameter by 30" long rebar pin with a 3" diameter aluminum cap stamped as follows: Iron County Remonumentation, T42N, R34W, R33W, R.M., 1/4, S-24, S-19, West, 20.86 feet, 1999, RLS 27457; T42N, R34W, R33W, R.M., 1/4, S-24, S-19, N 46° E, 38.41 feet, 1999, RLS 27457 from which I established the following new reference objects:

Sugar Maple	18"	N 84° E	27.75 feet
Balsam	7"	S 45° E	38.43 feet
Sugar Maple (dbl)	13"	N 36° W	40.56 feet
R.M.	5/8" x 30" rebar	East	20.86 feet
R.M.	5/8" x 30" rebar	S 46° W	38.41 feet
Steel sign post		East	21.68 feet

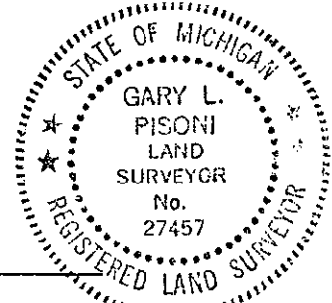

99-47
Signed by Gary L. Pisoni Date 12-28-99

Surveyor's Michigan License No. 27457