

MAR 09 2000

SECTION

LAND CORNER RECORDATION CERTIFICATE  
Filing Requirement of Act 74, Mich. P.A. 1970

For corners in

_____ Iron _____ (County)	Located In:	Corner Code #
1. Public Land Survey	T <u>42N</u> R <u>34W</u>	<u>M-9</u> ✓
	T <u>42N</u> R <u>33W</u>	<u>A-9</u>
	T _____ R _____	_____
	T _____ R _____	_____
2. Property Controlling in Section	S _____ T _____ R _____	_____
	S _____ T _____ R _____	_____
3. Miscellaneous Property in Sec.	S _____ T _____ R _____	_____
	S _____ T _____ R _____	_____

IRON COUNTY MICHIGAN  
RECEIVED FOR RECORD

99 DEC 30 AM 10:17  
L.C. Records: L. 8, P. 46  
*Gilbert Stedman*  
REGISTER OF DEEDS

Register of Deeds Stamp & File Number

4. Lot No. \_\_\_\_\_, Recorded Plat \_\_\_\_\_  
5. Private Claims \_\_\_\_\_

Section Corner to Sections 24 and 25, T42N, R34W  
Section Corner to Sections 19 and 30, T42N, R33W

I, Gary L. Pisoni, in a field survey on July 30, 1999 do hereby state that under requirements of P.A. 74, Michigan P.A. of 1970, the corner points mentioned in lines 1 and 2 above were in conformance with regulations and rules therefore as required in the current manual of survey instructions of the United States Department of the Interior, Bureau of Land Management or by a decree of a Court of Law and /or that the corner points mentioned in lines 3, 4 and 5 above were in conformance with the rules of the Michigan Board of Land Surveyors or by a Decree of a Court of Law; established, re-established, monumented, recovered, found as expressed below:

NOTE: Not more than 2 corners, all in the same town and range, may be recorded on this certificate.

	A	B	C	D	E	F	G	H	I	J	K	L	M
1													
2	6		5		4		3		2		1		
3													
4	7		8		9		10		11		12		
5													
6	18		17		16		15		14		13		
7													
8	19		20		21		22		23		24		
9													
10	30		29		28		27		26		25		
11													
12	31		32		33		34		35		36		
13													

A. Description of original monument and accessories and/or subsequent restoration:

Original corner established on Sept. 8, 1846 by Austin Burt, U.S. Deputy Surveyor.  
Original Corner; Ironwood Post  
Original Bearing Trees:  
Sugar 10" S 23° E 14 lks (9.24 feet)  
Sugar 10" N 84° W 23 lks (15.18 feet)  
In 1851, Guy H. Carleton, U.S Deputy Surveyor established the following new bearing trees:  
Sugar 16" N 60° E 43 lks (28.38 feet)  
Sugar 10" S 50° W 13 lks (8.58 feet)

PEER GROUP APPROVED  
*Iron Guy L. Pisoni 12-21-99*  
COUNTY REPRESENTATIVE


B. Description of corner evidence found and/or method applied in restoring or reestablishing corner:

No evidence of original B.T.s found.  
Found an iron bolt located in the centerline of a North/South county road and in line with an old fence line running East and West. Distances along the range line are consistent with GLO distances. I accept the iron bolt as the best available evidence for restoring the corner position.

Corner record research on file with County Representative.

C. Description of monument for corner and accessories established to perpetuate locating the position of the corner:  
Set two (2) reference monuments being a 5/8" diameter by 30" long rebar pin with a 3" diameter aluminum cap stamped as follows: Iron County Remonumentation, T42N, R34W, R33W, R.M., S-19, S-24, S-25, S-30, N 26°E, 67.48 feet, 1999, RLS 27457; T42N, R34W, R33W, R.M., S-19, S-24, S-25, S-30, East, 29.86 feet, 1999, RLS 27457 from which I established the following new reference objects:

Sugar Maple	11"	N 29° E	49.90 feet
Sugar Maple	7"	S 62° E	41.41 feet
Utility Pole	98-12227	S 26° W	77.70 feet
Basswood	8"	S 78° W	75.47 feet
R.M.	5/8" x 30" rebar	S 26° W	67.48 feet
R.M.	5/8" x 30" rebar	West	29.86 feet
Steel sign post		West	30.47 feet

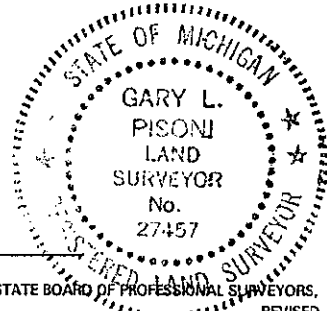

99-46  
Signed by Gary L. Pisoni Date 12-28-99

Surveyor's Michigan License No. 27457

FORM APPROVED BY MICHIGAN STATE BOARD OF PROFESSIONAL SURVEYORS, JAN. 28, 1971  
REVISED MAY 14, 1975  
REVISED JAN., 1983  
REVISED OCT., 1995