

LAND CORNER RECORDATION CERTIFICATE
Filing Requirement of Act 74, Mich. P.A. 1970 as Amended

For corners in

Iron	Located In:	Corner Code #
(County)		
1. Public Land Survey	T 42N R 34W	G8
	T 42N R 34W	H7
	T _____ R _____	_____
2. Property Controlling in Section	S _____ T _____ R _____	_____
	S _____ T _____ R _____	_____
3. Miscellaneous Property in Sec.	S _____ T _____ R _____	_____
	S _____ T _____ R _____	_____

Register of Deeds Stamp & File Number

4. Lot No. _____, Recorded Plat _____
 5. Private Claims _____

Apr 19 2004

I, Stephan J. Szyszkoski, in a field survey on _____, 20 ____ do hereby state that under requirements of P.A. 74, Michigan P.A. of 1970, the corner points mentioned in lines 1 and 2 above were in conformance with regulations and rules therefore as required in the current manual of survey instructions of the United States Department of the Interior, Bureau of Land Management or by a decree of a Court of Law and /or that the corner points mentioned in lines 3, 4 and 5 above were in conformance with the rules of the Michigan Board of Land Surveyors or by a Decree of a Court of Law; established, re-established, monumented, recovered, found as expressed below:

1	A	B	C	D	E	F	G	H	I	J	K	L	M
2		6		5		4		3		2		1	
3													
4		7		8		9		10		11		12	
5													
6		18		17		16		15		14		13	
7								●					
8		19		20		21		●		23		24	
9													
10		30		29		28		27		26		25	
11													
12		31		32		33		34		35		36	
13													

NOTE: Not more than 2 corners, all in the same town and range, may be recorded on this certificate.

A. Description of original monument and accessories and/or subsequent restoration:


(G8) Quarter corner common to Sections 21 and 22. Established in 1851 by Guy Carleton: "[south] corrected between 21&22...40.00 Set quarter post. Sugar 16 S60W 50 links, Sugar 10 N46E 18 links...79.32 Intersect left bank of Brule River and set meander post...[east] on true line between Sections 22&27. Offset East 90 links thence South 68 links into East and West line. Therefore at 90 [links] line leaves river and set meander post". Old Chicago and Northwestern Railroad plans show a distance of 2340' south from G8 to the centerline of the railroad. No subsequent record was found.
 (H7) Quarter corner common to Sections 15&22. Established in 1851 by Guy Carleton: "[east] corrected between Sections 15&22...40.00 Set quarter post. Yellow Birch 10 S16W 19 links, Yellow Birch 18 N60E 16 links...80.00 Set post corner of Sections 14-15-22-23. Found no subsequent record.

B. Description of corner evidence found and/or method applied in restoring or reestablishing corner:

(G8) The original post and accessories were not recovered. Reestablished the position for the corner by single proportionate measurement to the original record between G7 and the reestablished position of the original meander corner between Sections 21 and 22. The distance G7 to G8 is 2627.44', or 40 chains with the application of the average observed index correction for this area of the township. The distance from G8 to the centerline of the old Chicago and Northwestern RR R/W was found to be 2347 feet. Extrapolating from the Plat of Saunders in the SW1/4 of Sec. 21 makes a very unreasonable position for this corner, not agreeing with any of the original record, and the Plat of Saunders was not used to reestablish this corner.
 (H7) The original post and accessories were not recovered. Reestablished the corner by single proportionate measurement to the original record between Section corners 2632.81' east and west. From the corner thus established I found a 1.25" O.D. thick-walled iron pipe, projecting 12" with a 4' tall drill rod adjacent, set by persons unknown, S6W 84.5' distant, which I did not accept for the corner.

C. Description of monument for corner and accessories established to perpetuate locating the position of the corner:

(G8) Set 1" IDx32" I.pipe with 4" alum. MDNR cap. Blazed, scribed, and set measuring nails in: 5" Sugar N51E 24.7' "1/4S NBT" 5" Sugar N85E 15.1' do 5" Sugar S20E 19.2' do 5" Sugar N89W 6.1' do Bearings are magnetic. Distances are to nail with tag.	(H7) Set 1" IDx32" I.pipe with 4" alum. MDNR cap. Blazed, scribed, and set measuring nails in: 10" Sugar N27E 28.5' "1/4S NBT" 5" Sugar S33E 46.1' do 9" Sugar S15W 34.4' do 8" Sugar N63W 25.9' do Set squared cedar post adjacent. Bearings are magnetic. Distances are to nail with tag.
--	--

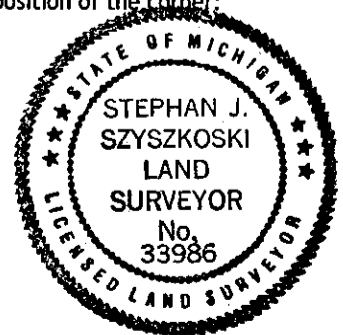

Signed by Stephan J. Szyszkoski
 Surveyor's Michigan License No. 33986

Date 6/17/04