

LAND CORNER RECORDATION CERTIFICATE
Filing Requirement of Act 74, Mich. P.A. 1970 as Amended

For corners in

Iron	Located In:	Corner Code #
<small>(County)</small>		
1. Public Land Survey	T 42N R 34W	MC-2 S. of I8
	T 42N R 34W	MC-3 S. of I8
	T _____ R _____	_____
2. Property Controlling	S _____ T _____ R _____	_____
in Section	S _____ T _____ R _____	_____
3. Miscellaneous	S _____ T _____ R _____	_____
Property in Sec.	S _____ T _____ R _____	_____

Register of Deeds Stamp & File
Number

4. Lot No. _____, Recorded Plat _____
 5. Private Claims _____

May 05 2004

I, Stephan J. Szyszkoski, in a field survey on _____, 20____ do hereby state that under requirements of P.A. 74, Michigan P.A. of 1970, the corner points mentioned in lines 1 and 2 above were in conformance with regulations and rules therefore as required in the current manual of survey instructions of the United States Department of the Interior, Bureau of Land Management or by a decree of a Court of Law and /or that the corner points mentioned in lines 3, 4 and 5 above were in conformance with the rules of the Michigan Board of Land Surveyors or by a Decree of a Court of Law; established, re-established, monumented, recovered, found as expressed below:

NOTE: Not more than 2 corners, all in the same town and range, may be recorded on this certificate.

	A	B	C	D	E	F	G	H	I	J	K	L	M
1													
2	6		5		4		3		2		1		
3													
4	7		8		9		10		11		12		
5													
6	18		17		16		15		14		13		
7													
8	19		20		21		22		23		24		
9													
10	30		29		28		27		26		25		
11													
12	31		32		33		34		35		36		
13													

A. Description of original monument and accessories and/or subsequent restoration:

(MC-2 S. of I8) Second Meander corner south of I8 on the Section line between 22 & 23. Established in 1851 by Guy Carleton: "[south] on true line between 22 & 23...40.00 Set quarter post...52.76 Line leaves River Set Meander post. Cedar 10 for corner, Cedar 8 S17W 10 links."

(MC-3 S. of I8) Third Meander Corner South of I8 on the line between Sections 22 & 23. Established in 1851 by Guy Carleton: "[south] on true line between Sections 22 & 23... 40.00 Set quarter post...62.16 Intersect Left Bank of Brule River and set Meander post. Cedar 8 for corner, Cedar 5 S4W 13 links."


B. Description of corner evidence found and/or method applied in restoring or reestablishing corner:

(MC-2 S. of I8) The original corner tree and accessory were not recovered. Reestablished the corner at the intersection of the Section line between 22&23 with the Left Bank of the Brule River. The Section line is an extension of the line between I7 and I8. Distances north and south to adjacent Meander Corner monuments are 313.85' and 472.51', respectively.

(MC-3 S. of I8) The original corner tree and accessory were not recovered. Reestablished the corner at the intersection of the Left Bank of the Brule River as it exists today with the Section line between Sections 22 & 23. The Section line is an extension of the line between I7 and I8. Distance from the MC to I8 was found to be 1415.27' (1463' GLO).

C. Description of monument for corner and accessories established to perpetuate locating the position of the corner:

(MC-2) Set 1"IDx32" I.pipe with 4" alum. MDNR cap stamped to read "MIT COR SEC 22 SEC 23". Blazed, scribed, and set measuring nails in: 7" B.Ash N76W 37.1' "MC BT" 6" B.Ash S78W 42.5' do 6" B.Ash S14W 43.8' do 7" B.Ash S19E 14.3' do Set a sq'd cedar post adjacent. Bearings are magnetic. Distances are to nail with tag.	(MC) Set 1"IDx32" I.pipe with 4" alum. MDNR cap stamped to read "MIT COR SEC 22 SEC23". Blazed, scribed, and set measuring nails in: 7" Sugar N13E 47.4' "MC BT" 9" Sugar N62E 20.4' do 4" B.Ash S17W 13.0' do 6" Sugar N70W 43.2' do Set sq'd cedar post adjacent. Bearings are magnetic. Distances are to nail with tag.
---	--

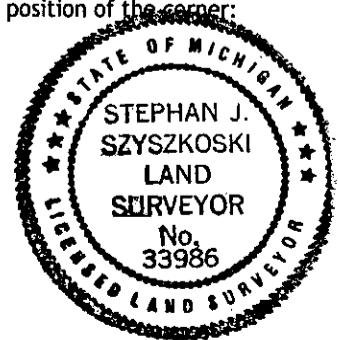

Signed by Stephan J. Szyszkoski
 Surveyor's Michigan License No. 33986

Date 6/17/04

For the Michigan Department of Natural Resources, Office of Land and Facilities