

**LAND CORNER RECORDATION CERTIFICATE**  
**Filing Requirement of Act 74, Mich. P.A. 1970 as Amended**

For corners in

<u>Iron</u>	Located In:	Corner Code #
<small>(County)</small>		
1. Public Land Survey	T <u>42N</u> R <u>34W</u>	<u>MC-1 S. of I8</u>
	T _____ R _____	_____
	T _____ R _____	_____
2. Property Controlling in Section	S _____ T _____ R _____	_____
	S _____ T _____ R _____	_____
3. Miscellaneous Property in Sec.	S _____ T _____ R _____	_____
	S _____ T _____ R _____	_____

Register of Deeds Stamp & File  
Number

4. Lot No. \_\_\_\_\_, Recorded Plat \_\_\_\_\_  
 5. Private Claims

May 05 2004

I, Stephan J. Szyszkoski, in a field survey on \_\_\_\_\_, 20\_\_\_\_ do hereby state that under requirements of P.A. 74, Michigan P.A. of 1970, the corner points mentioned in lines 1 and 2 above were in conformance with regulations and rules therefore as required in the current manual of survey instructions of the United States Department of the Interior, Bureau of Land Management or by a decree of a Court of Law and /or that the corner points mentioned in lines 3, 4 and 5 above were in conformance with the rules of the Michigan Board of Land Surveyors or by a Decree of a Court of Law; established, re-established, monumented, recovered, found as expressed below:

**NOTE: Not more than 2 corners, all in the same town and range, may be recorded on this certificate.**

A. Description of original monument and accessories and/or subsequent restoration:


(MC-1 S. of I8) The first Meander Corner south of I8 on the line between Sections 22 and 23. Established in 1851 by Guy Carleton: "[south] on true line between Sections 22&23...40.00°Set quarter post...44.76 Intersect Left Bank of Brule River and set Meander post. Elm 12 N35E 40 links, Fir 12 N42W 11 links."

B. Description of corner evidence found and/or method applied in restoring or reestablishing corner:

(MC-1 S. of I8) The original post and accessories were not recovered. Reestablished the corner on the Left Bank of the Brule River and on the Section line between Sections 22 & 23 at record distance south of I8 (prorated to the original record using the ratio of measured length to record length observed between I7 and I8). The distance from the Meander Corner to I8 is 313.85' (4.76 ch. GLO). The Section line between 22&23 is an extension of the line between I7 and I8.

C. Description of monument for corner and accessories established to perpetuate locating the position of the corner:

(MC) Set 1"IDx32" I.pipe with 4" alum.  
 MDNR cap. Blazed, scribed, and set  
 measuring nails in:  
 7" B.Ash S72W 14.6' "MC NBT"  
 7" B.Ash S88W 9.5' do  
 4" Maple N24E 30.9' do  
 9" B.Ash N58E 0.9' do  
 Set sq'd spruce post adjacent. Bearings  
 are magnetic. Distances are to nail  
 with tag.

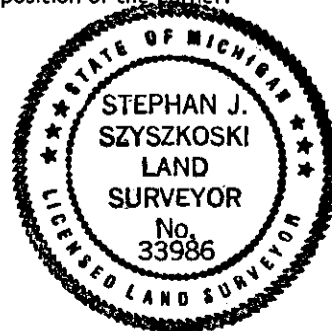

Signed by Stephan J. Szyszkoski  
 Surveyor's Michigan License No. 33986

Date 6/17/04

For the Michigan Department of Natural Resources, Office of Land and Facilities