

LAND CORNER RECORDATION CERTIFICATE
Filing Requirement of Act 74, Mich. P.A. 1970 as Amended

For corners in

Iron	Located In:	Corner Code #
<small>(County)</small>		
1. Public Land Survey	T <u>42N</u> R <u>34W</u>	<u>F7</u>
	T _____ R _____	_____
	T _____ R _____	_____
2. Property Controlling in Section	S _____ T _____ R _____	_____
	S <u>22</u> T <u>42N</u> R <u>34W</u>	<u>1</u>
	S _____ T _____ R _____	_____
3. Miscellaneous Property in Sec.	S _____ T _____ R _____	_____
	S _____ T _____ R _____	_____

Register of Deeds Stamp & File
Number

4. Lot No. _____, Recorded Plat _____

5. Private Claims

F7 Apr 26 2004
1 Apr 21 2004

	A	B	C	D	E	F	G	H	I	J	K	L	M
1													
2	6	5	4	3	2	1							
3													
4	7	8	9	10	11	12							
5													
6	18	17	16	15	14	13							
7							●	●					
8	19	20	21	22	23	24							
9													
10	30	29	28	27	26	25							
11													
12	31	32	33	34	35	36							
13													

I, Stephan J. Szyszkoski, in a field survey on _____, 20____ do hereby state that under requirements of P.A. 74, Michigan P.A. of 1970, the corner points mentioned in lines 1 and 2 above were in conformance with regulations and rules therefore as required in the current manual of survey instructions of the United States Department of the Interior, Bureau of Land Management or by a decree of a Court of Law and /or that the corner points mentioned in lines 3, 4 and 5 above were in conformance with the rules of the Michigan Board of Land Surveyors or by a Decree of a Court of Law; established, re-established, monumented, recovered, found as expressed below:

NOTE: Not more than 2 corners, all in the same town and range, may be recorded on this certificate.

A. Description of original monument and accessories and/or subsequent restoration:


(F7) Quarter corner common to Sections 16 and 21. Established in 1851 by Guy Carleton: "[east] corrected between 16&21...40.00 Set quarter post. Sugar 14 N53W 40 links, Hemlock 22 S53E 13 links... 80.00 set post corner of Sections 15,16,21,22". Notes acquired from Gary Pisoni, PS, in 1984 show, at the midpoint between E7 and G7 "no cor. set or found".
 (1-Sec. 22) West 1/16 corner between Sections 15 and 22. Not established in the original survey.

B. Description of corner evidence found and/or method applied in restoring or reestablishing corner:

(F7) The original post and accessories were not recovered. Recovered no evidence of prior monumentation. Reestablished the corner by single proportionate measurement to the original record between Section corners 2623.38' East and West.
 (1-Sec. 22) Established the corner midway and on a line of mean true bearing between Section corner 1316.43' West and Quarter corner 1316.43' East.

C. Description of monument for corner and accessories established to perpetuate locating the position of the corner:

(F7) Set 1"IDx32" I.pipe with 4" alum. MDNR cap. Blazed, scribed, and set measuring nails in: 10" Maple N08E 35.0' "1/4S NBT" 6" Sugar in clump N69E 27.1' do 7" Sugar in clump S24E 18.6' do 6" Sugar N79W 28.7' do Set sq'd cedar post adjacent. Bearings are magnetic. Distances are to nail with tag.	(1) Set 1"IDx32" I.pipe with 4" alum. MDNR cap. Blazed, scribed, and set measuring nails in: 10" Hemlock S75E 37.3' "1/16S BT" 8" Basswood S01E 36.8' do 9" Sugar S87W 41.6' do 10" B.Ash N22E 50.1' do Set sq'd cedar post adjacent. Bearings are magnetic. Distances are to nail with tag.
--	---

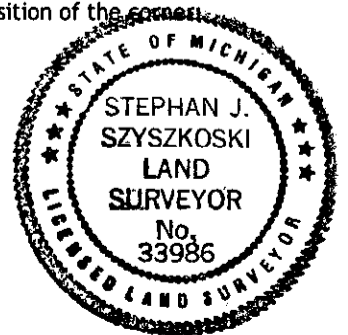

Signed by Stephan J. Szyszkoski
 Surveyor's Michigan License No. 33986

Date 6/17/04

For the Michigan Department of Natural Resources, Office of Land and Facilities