

**LAND CORNER RECORDATION CERTIFICATE**  
**Filing Requirement of Act 74, Mich. P.A. 1970 as Amended**

For corners in

<u>Iron</u> (County)	Located In:	Corner Code #
1. Public Land Survey	T <u>42NR</u> <u>34W</u>	<u>MC East of A11</u>
	T _____ R _____	_____
	T _____ R _____	_____
2. Property Controlling in Section	S _____ T <u>42NR</u> <u>34W</u>	<u>PCC East of A10</u>
	S _____ T _____ R _____	_____
3. Miscellaneous Property in Sec.	S _____ T _____ R _____	_____
	S _____ T _____ R _____	_____

Register of Deeds Stamp & File Number

4. Lot No. \_\_\_\_\_, Recorded Plat \_\_\_\_\_  
 5. Private Claims \_\_\_\_\_

Feb 21 2006

I, Stephan J. Szyszkoski, in a field survey on \_\_\_\_\_, 20\_\_\_\_ do hereby state that under requirements of P.A. 74, Michigan P.A. of 1970, the corner points mentioned in lines 1 and 2 above were in conformance with regulations and rules therefore as required in the current manual of survey instructions of the United States Department of the Interior, Bureau of Land Management or by a decree of a Court of Law and /or that the corner points mentioned in lines 3, 4 and 5 above were in conformance with the rules of the Michigan Board of Land Surveyors or by a Decree of a Court of Law; established, re-established, monumented, recovered, found as expressed below:

**NOTE: Not more than 2 corners, all in the same town and range, may be recorded on this certificate.**

	A	B	C	D	E	F	G	H	I	J	K	L	M
1													
2	6		5		4		3		2		1		
3													
4	7		8		9		10		11		12		
5													
6	18		17		16		15		14		13		
7													
8	19		20		21		22		23		24		
9													
10	30		29		28		27		26		25		
11													
12	31		32		33		34		35		36		
13													

A. Description of original monument and accessories and/or subsequent restoration:

(MC East of A11) Meander corner between Sections 30 and 31 on the left bank of the Brule River. 1851 - Established by Guy Carleton, Deputy Surveyor: " N 89 deg. 38'E On True Line between Sections 30 and 31 ...14.20 Intersect River and set meander post = that is Left Bank of Brule River. Cedar 10 N18W 23 links, Spruce 10 S42W 16 links". Carleton's record show that the north and south lines of Section 30 were run in on the same bearing.

(PCC East of A10) a Property Controlling Corner marking the E-W 1/4 line of Section 30, T42N-R34W. Not established in the original survey.

B. Description of corner evidence found and/or method applied in restoring or reestablishing corner:


(MC East of A11) The original post and accessories were not recovered. Reestablished the corner at record distance (14.20 chains) East of Corner A11 and on a line through A11 which is parallel to the North line of Section 30. From the position thus established, I set a WITNESS CORNER 6.07' East and on the Section line. The MC is 15' west of the left bank of the Brule River.

(PCC East of A10) Established the E-W 1/4 line parallel to the monumented north line of Section 30 and passing through corner A10 as monumented by the Iron County Remonumentation Program. This PCC is located 1354.37' east of A10. The Brule River is some 700'-800' further east. No other monumentation was placed along the E-W 1/4 line during this survey.

C. Description of monument for corner and accessories established to perpetuate locating the position of the corner:

(MC) Set 1"IDx32" I.pipe with 4" alum. MDNR cap for a MC 6.07' East of the MC position. Set measuring nails in:  
 9" B.Spruce N69W 57.6' mrkd "WMCB BT"  
 7" B.Spruce S45W 23.4' do  
 9" Cedar S64W 27.5' do  
 11" Cedar S71W 29.5' do  
 Set sq'd cedar post adjacent. Bearings are magnetic. Distances are to nail with tag.

(PCC) Set 1"IDx32" I.pipe with 4" alum. MDNR cap on the E-W 1/4 line. Set measuring nails in:  
 7" B.Spruce N06W 6.2' mrkd with blaze  
 8" B.Spruce N30W 5.7' do  
 10" Cedar S16E 45.0' do  
 8" Cedar S58E 32.1' do  
 Set sq'd cedar post adjacent. Bearings are magnetic. Distances are to nail with tag.

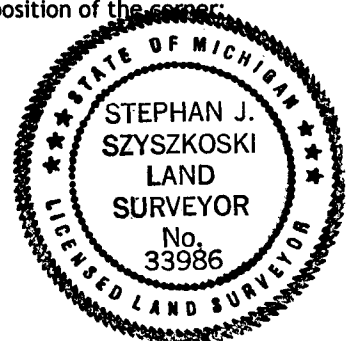

Signed by Stephan J. Szyszkoski  
 Surveyor's Michigan License No. 33986

Date 6/13/06

For the Michigan Department of Natural Resources, Office of Land and Facilities