

**SURVEY & REMONUMENTATION**

1993

**COMMISSION**

**LAND CORNER RECORDATION CERTIFICATE**  
 Filing Requirement of Act 74, Mich. P.A. 1970

IRON COUNTY  
 MICHIGAN  
 RECEIVED FOR RECORD  
 93 DEC 29 PM 2:20  
 L.C. RECORDS L.C. P. 288  
*Gilbert Stebbins*  
 REGISTER OF DEEDS

For corners in

Iron (County)	Located in:	Corner Code #
1. Public Land Survey	T <u>42N</u> R <u>35W</u>	B-5
	T _____ R _____	_____
	T _____ R _____	_____
	T _____ R _____	_____
2. Property Controlling in Section	S _____ T _____ R _____	_____
	S _____ T _____ R _____	_____
3. Miscellaneous Property in Sec.	S _____ T _____ R _____	_____
	S _____ T _____ R _____	_____
4. Lot No. _____, Recorded Plat _____		
5. Private Claims _____		

Register of Deeds Stamp & File Number

Quarter Corner 7-18 T42N R35W

I, Gary L. Pisoni in a field survey on December 18, 1993, do hereby certify that under requirements of P.A. 74, Michigan P.A. of 1970, the corner points mentioned in lines 1 and 2 above were in conformance with regulations and rules therefore as required in the current manual of survey instructions of the United States Department of the Interior, Bureau of Land Management or by a decree of a Court of Law and/or that the corner points mentioned in lines 3, 4 and 5 above were in conformance with the rules of the Michigan Board of Land Surveyors or by a Decree of a Court of Law; established, re-established, monumented, re-monumented, recovered, found as expressed below:

	A	B	C	D	E	F	G	H	I	J	K	L	M
2	6	5	4	3	2	1							
3													
4	7	8	9	10	11	12							
5													
6	18	17	16	15	14	13							
7													
8	19	20	21	22	23	24							
9													
10	30	29	28	27	26	25							
11													
12	31	32	33	34	35	36							
13													

**NOTE: Not more than 4 corners, all in the same town and range, may be recorded on this certificate.**

**A. Description of original monument and accessories and/or subsequent restoration:**

Original corner established by Harvey Mellen, U.S. Deputy Surveyor on August 20, 1851.  
 Original corner: Wood post  
 Original bearing trees:  
     Sugar Maple                      14"                      S 32° W                      8 links ( 5.28 feet)  
     Yellow Birch                      14"                      S 47° E                      19 links (12.54 feet)

**B. Description of corner evidence found and/or method applied in restoring or reestablishing corner:**


No evidence of original corner or bearing tree remains. Corner position found marked by a 5" X 44" cylindrical plat concrete monument of Camp Lake. Concrete monument in poor condition, reset with an aluminum pipe monument as described below. Monument is 3" above ground surface. Corner position has been used and accepted as the corner locally, for many years. Layed plat concrete monument next to monument.

This corner is accepted as the best available evidence of the position of the original corner.

**C. Description of monument for corner and accessories established to perpetuate locating the position of the corner:**

At the corner position, I set a 2" diameter by 30" long split base aluminum pipe monument with a 3" cast aluminum cap, stamped to read: Iron County Remonumentation, T42N, R35W, 1/4, S-7, S-18, 1993, R.L.S. 27457; from which I established the following new blazed and scribed bearing trees: (all measurement taken to a nail in side of tree)

Basswood	9"	N 61° E	5.54 feet
Sugar Maple	7"	S 18° E	20.98 feet
Ash	6"	N 88° W	14.36 feet
Ash	6"	N 28° W	9.85 feet
Steel sign post		North	1.16 feet

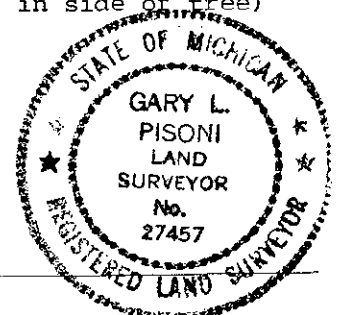

Signed by Gary L. Pisoni

Date 12-28-93

Surveyor's Michigan License No. 27457