

FEB 22 1996

**COMMISSION**

**LAND CORNER RECORDATION CERTIFICATE**  
**Filing Requirement of Act 74, Mich. P.A. 1970**

For corners in

<u>Iron</u> (County)	Located In:	Corner Code #:
1. Public Land Survey	T 42N R 35W	<u>C-1</u>
	T 43N R 35W	C-13
	T _____ R _____	_____
	T _____ R _____	_____
2. Property Controlling in Section	S _____ T _____ R _____	_____
	S _____ T _____ R _____	_____
3. Miscellaneous Property in Sec.	S _____ T _____ R _____	_____
	S _____ T _____ R _____	_____
4. Lot No. _____, Recorded Plat _____		
5. Private Claims _____		

REGISTRAR'S OFFICE )  
 IRON COUNTY, MICH. ) ..SS  
 RECEIVED FOR RECORD THE 21<sup>ST</sup> DAY OF  
FEBRUARY A.D. 19 95 AT  
2:45 O'CLOCK P M., AND RECORDED IN LIBER  
6 OF L.C. RECORDS  
 ON PAGE 375  
Michael DeWitt  
 DEPUTY REGISTER OF DEEDS  
**Register of Deeds Stamp & File Number**

Section Corner 31, 32, 6, 5, T43N, R35W  
 T42N  
 Gary L. Pisoni, in a field survey on October 26, 1994  
 do hereby certify that under requirements of P.A. 74, Michigan P.A. of 1970, the corner points mentioned in lines 1 and 2 above were in conformance with regulations and rules therefore as required in the current manual of survey instructions of the United States Department of the Interior, Bureau of Land Management or by a decree of a Court of Law and/or that the corner points mentioned in lines 3, 4 and 5 above were in conformance with the rules of the Michigan Board of Land Surveyors or by a Decree of a Court of Law; established, re-established, monumented, re-monumented, recovered, found as expressed below:

A	B	C	D	E	F	G	H	I	J	K	L	M
2	6	5	4	3	2	1						
3												
4	7	8	9	10	11	12						
5												
6	18	17	16	15	14	13						
7												
8	19	20	21	22	23	24						
9												
10	30	29	28	27	26	25						
11												
12	31	32	33	34	35	36						
13												

**NOTE: Not more than 4 corners, all in the same town and range, may be recorded on this certificate.**

**A. Description of original monument and accessories and/or subsequent restoration:**

Original corner established by John Burt, U.S. Deputy Surveyor in 1846.  
 Original corner: Sugar Post  
 Original bearing trees:  
     Yellow Birch                      6"                      N 57° E                      68 links (44.88 feet)  
     Sugar Maple                      16"                      N 57° W                      39 links (25.74 feet)  
 Original corner recovered by Harvey Mellen, U.S. Deputy Surveyor in 1851.  
 Original bearing trees:  
     Sugar                                  12"                      S 68° E                      25 links (16.50 feet)  
     Sugar                                  20"                      S 76½° W                      69 links (45.54 feet)

**B. Description of corner evidence found and/or method applied in restoring or reestablishing corner:**

No evidence of original corner or bearing tree remains. Donald D. Lappala RLS for the U.S. Forest Service set an iron bar located in the intersection of an East/West and North County roads and according to local residents stated that the corner position has been used for more than 50 years. Mr. Lappala recorded this corner in Liber 3, Page 16. Found the iron bar as stated above and placed an aluminum pipe monument over the top of the iron bar as described below. Monument is 6" below road bed surface.

This corner is accepted as the best available evidence of the position of the original corner.


County Record Research on file with County Representative Office.

**PEER GROUP APPROVED**  
*by Iron County Gary L. Pisoni*  
**COUNTY REPRESENTATIVE**

**C. Description of monument for corner and accessories established to perpetuate locating the position of the corner:**

At the corner position, I set a 2" diameter by 30" long split base aluminum pipe monument with a 3" cast aluminum cap, stamped to read: Iron County Remonumentation, T43N, R35W, S-31, S-32, S-6, S-5, T42N, 1994, RLS- 27457 from which I established the following new blazed and scribed bearing trees: (all measurements taken to a nail in side of tree)

Existing	Sugar Maple	13"	S 63° E	111.39 feet
"	Sugar Maple	9"	S 35° W	56.30 feet
Brass Cap Ref. Monument	2" dia. Iron Pipe		South	32.05 feet
	Rebar	5/8" x 30"	N 49° W	42.70 feet
	Sugar Maple	12"	N 25° E	82.23 feet
	Steel Sign Post		South	32.70 feet

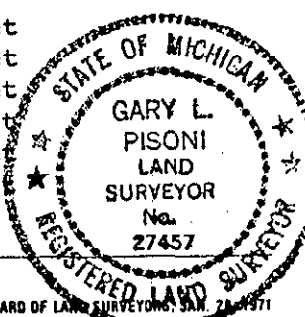

Signed by Gary L. Pisoni Date 1-9-95

Surveyor's Michigan License No. 27457