

1993

LAND CORNER RECORDATION CERTIFICATE
Filing Requirement of Act 74, Mich. P.A. 1970

93 DEC 29 PM 2:20
L.C. RECORDS L. 6 P. 291

COMMISSION

Gilbert Stebbins
REGISTER OF DEEDS

For corners in

<u>Iron</u> (County)	Located In:	Corner Code #
1. Public Land Survey	T <u>42N</u> R <u>35W</u>	<u>E-3</u>
	T _____ R _____	_____
	T _____ R _____	_____
	T _____ R _____	_____
2. Property Controlling in Section	S _____ T _____ R _____	_____
	S _____ T _____ R _____	_____
3. Miscellaneous Property in Sec.	S _____ T _____ R _____	_____
	S _____ T _____ R _____	_____

Register of Deeds Stamp & File Number

4. Lot No. _____, Recorded Plat _____
5. Private Claims _____

Section Corner 5-4-8-9 T42N R35W

I, Gary L. Pisoni, in a field survey on December 18, 1993
do hereby certify that under requirements of P.A. 74, Michigan P.A. of 1970, the corner points mentioned
in lines 1 and 2 above were in conformance with regulations and rules therefore as required in the
current manual of survey instructions of the United States Department of the Interior, Bureau of Land
Management or by a decree of a Court of Law and/or that the corner points mentioned in lines 3, 4 and 5
above were in conformance with the rules of the Michigan Board of Land Surveyors or by a Decree of a
Court of Law; established, re-established, monumented, re-monumented, recovered, found as
expressed below:

A	B	C	D	E	F	G	H	I	J	K	L	M
2	6	5	4	3	2	1						
3												
4	7	8	9	10	11	12						
5												
6	18	17	16	15	14	13						
7												
8	19	20	21	22	23	24						
9												
10	30	29	28	27	26	25						
11												
12	31	32	33	34	35	36						
13												

NOTE: Not more than 4 corners, all in the same town and range, may be recorded on this certificate.

A. Description of original monument and accessories and/or subsequent restoration:

Original corner established by Harvey Mellen, U.S. Deputy Surveyor on August 16, 1851.
Original corner: Wood Post
Original bearing trees:
Lynn 14" S 62° E 25 links (16.50 feet)
Sugar Maple 12" N 24° W 24 links (15.84 feet)

B. Description of corner evidence found and/or method applied in restoring or reestablishing corner:


No evidence of original corner or bearing tree remains. Corner position found marked by a 32" Roof Bolt. Roof Bolt being part of the Stanley Lake Plat. Set an aluminum pipe monument over the top of iron Roof Bolt as described below. Monument located on the West shoulder of the Stanley Lake boat access road. Monument is 3" below ground surface.

This corner is accepted as the best available evidence of the position of the original corner.

C. Description of monument for corner and accessories established to perpetuate locating the position of the corner:

At the corner position, I set a 2" diameter by 30" long split base aluminum pipe monument with a 3" cast aluminum cap, stamped to read: Iron County Remonumentation, T42N, R35W, S-5, S-4, S-8, S-9, 1993, R.L.S. 27457; from which I established the following new blazed and scribed bearing trees: (all measurements taken to a nail in side of tree)

Sugar Maple	12"	N 43° E	51.86 feet
Utility Transformer Pole	M-6-12-1	S 52° W	75.23 feet
Basswood	12"	N 26° W	43.14 feet
Plat concrete mon.	5" dia.	West	32.95 feet
Steel rail		West	8.12 feet

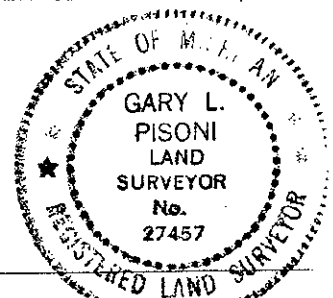

Signed by Gary L. Pisoni

Date 12-28-93

Surveyor's Michigan License No. 27457