

FEB 22 1996

COMMISSION

**LAND CORNER RECORDATION CERTIFICATE**  
**Filing Requirement of Act 74, Mich. P.A. 1970**

For corners in

Located in: Iron (County) Corner Code #

1. Public Land Survey	T <u>42N</u> R <u>35W</u>	<u>G-1</u>
	T <u>43N</u> R <u>35W</u>	<u>G-13</u>
	T _____ R _____	_____
	T _____ R _____	_____
2. Property Controlling in Section	S _____ T _____ R _____	_____
	S _____ T _____ R _____	_____
3. Miscellaneous Property in Sec.	S _____ T _____ R _____	_____
	S _____ T _____ R _____	_____
4. Lot No. _____, Recorded Plat _____		
5. Private Claims _____		

REGISTER'S OFFICE )  
 IRON COUNTY, MICH. ) ..SS  
 RECEIVED FOR RECORD THE 21<sup>ST</sup> DAY OF  
FEBRUARY A.D. 19 95 AT  
2:45 O'CLOCK P. M. AND RECORDED IN LIBER  
6 OF L.C. RECORDS  
 ON PAGE 360  
Maui Selma  
 DEPUTY REGISTER OF DEEDS  
**Register of Deeds Stamp & File Number**

Section Corner 33, 34, 4, 3, T43N, R35W  
T42N  
 I, Gary L. Pisoni, in a field survey on September 15, 19 94,  
 do hereby certify that under requirements of P.A. 74 Michigan P.A. of 1970, the corner points mentioned  
 in lines 1 and 2 above were in conformance with regulations and rules therefore as required in the  
 current manual of survey instructions of the United States Department of the Interior, Bureau of Land  
 Management or by a decree of a Court of Law and/or that the corner points mentioned in lines 3, 4 and 5  
 above were in conformance with the rules of the Michigan Board of Land Surveyors or by a Decree of a  
 Court of Law; established, re-established, monumented, re-monumented, recovered, found as  
 expressed below:

A	B	C	D	E	F	G	H	I	J	K	L	M
2	6	5	4	3	2	1						
3												
4	7	8	9	10	11	12						
5												
6	16	17	16	15	14	13						
7												
8	19	20	21	22	23	24						
9												
10	30	29	28	27	26	25						
11												
12	31	32	33	34	35	36						
13												

**NOTE: Not more than 4 corners, all in the same town and range, may be recorded on this certificate.**

**A. Description of original monument and accessories and/or subsequent restoration:**

Original corner established by John Burt, U.S. Deputy Surveyor in 1846.  
 Original corner: Hemlock Post  
 Original bearing trees:  
     Sugar                      14"                      N 37° E                      33 links (21.78 feet)  
     Sugar                      6"                      N 55° W                      42 links (27.72 feet)

Original corner recovered by Harvey Mellen, U.S. Deputy Surveyor in 1851.  
 Original bearing trees:  
     Yellow Birch              24"                      S 47° W                      19 links (12.54 feet)  
     Hemlock                    10"                      S 63° E                      38 links (25.08 feet)

**B. Description of corner evidence found and/or method applied in restoring or reestablishing corner:**

No evidence of original corner or bearing tree remains. Corner position found marked by a 1" x 30" drill rod and located in the centerline of a North/South county road and in the centerline of a county road running East. Corner position has been used and accepted as the corner locally for many years. Set an aluminum pipe monument over the top of the drill rod as described below. Monument is flush with ground surface.

This corner is accepted as the best available evidence of the position of the original corner.


County Record Research on file with County Representatives Office.

**PEER GROUP APPROVED**  
Iron Gary J. Pisoni  
 COUNTY REPRESENTATIVE  
 A.P. 11-30-94

**C. Description of monument for corner and accessories established to perpetuate locating the position of the corner:**

At the corner position, I set a 2" diameter by 30" long split base aluminum pipe monument with a 3" cast aluminum cap, stamped to read: Iron County Remonumentation, T43N, R35W, S-33, S-34, S-4, S-3, T42N, 1994, RLS- 37457 from which I established the following new blazed and scribed bearing trees: (all measurements taken to a nail in side of tree)

Utility Pole	#M6-2-18	N 56° E	42.48 feet
Rebar	5/8" x 30"	S 49° E	76.85 feet
Yellow Birch	13"	S 33° W	57.74 feet
Rebar	5/8" x 30"	N 31° W	28.35 feet
Steel Sign Post		N 47° W	1.12 feet

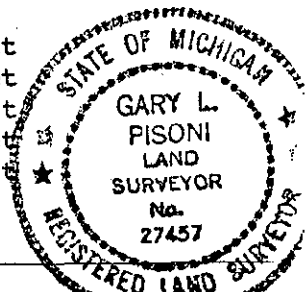

Signed by Gary L. Pisoni Date 1-9-95  
 Surveyor's Michigan License No. 27457