

MAR 09 2000

SECTION

LAND CORNER RECORDATION CERTIFICATE
Filing Requirement of Act 74, Mich. P.A. 1970

For corners in

Form with fields for Iron (County), Located In, Corner Code #, and survey types: 1. Public Land Survey, 2. Property Controlling in Section, 3. Miscellaneous Property in Sec.

IRON COUNTY MICHIGAN RECEIVED FOR RECORD 99 DEC 30 AM 10:35 L.C. Records: L. 8, P. 140 Register of Deeds Stamp & File Number

4. Lot No. , Recorded Plat
5. Private Claims

Section Corner to Sections 15, 16, 21, 22, T42N, R35W

I, Gary L. Pisoni, in a field survey on Nov. 27, 1999 do hereby state that under requirements of P.A. 74, Michigan P.A. of 1970, the corner points mentioned in lines 1 and 2 above were in conformance with regulations and rules therefore as required in the current manual of survey instructions of the United States Department of the Interior, Bureau of Land Management or by a decree of a Court of Law and /or that the corner points mentioned in lines 3, 4 and 5 above were in conformance with the rules of the Michigan Board of Land Surveyors or by a Decree of a Court of Law; established, re-established, monumented, recovered, found as expressed below:

Grid table with columns A-M and rows 1-13, showing a grid of numbers and a central dot at row 7, column H.

NOTE: Not more than 2 corners, all in the same town and range, may be recorded on this certificate.

A. Description of original monument and accessories and/or subsequent restoration:

Original corner established on August 15, 1851 by Harvey Mellen, U.S. Deputy Surveyor. Original Corner; Wood Post Original Bearing Trees: Hemlock 14" S 56° W 64 lks (42.24 feet) Yellow Birch 20" N 11° E 30 lks (19.80 feet)


PEER GROUP APPROVED Iron County Rep 12-21-99 COUNTY REPRESENTATIVE

B. Description of corner evidence found and/or method applied in restoring or reestablishing corner:

No evidence of original B.T.s found. Found an iron bar and wood post in line with the centerline of a county road running East and South. I accept the iron bar as the best available evidence for restoring the corner position. Corner record research on file with County Representative.

C. Description of monument for corner and accessories established to perpetuate locating the position of the corner:

Over the top of the existing iron bar, set a 2" diameter by 30" long split base aluminum pipe monument, with a 3" dia. aluminum cap stamped as follows: Iron County Remonumentation, T42N, R35W, S-16, S-15, S-21, S-22, 1999, RLS 27457 from which I established the following new blazed and scribed bearing trees:(All measurements taken to a nail in side of tree) Sugar Maple (dbl) 14" S 52° E 6.19 feet Sugar Maple 8" S 50° W 19.00 feet Sugar Maple 13" S 70° W 35.70 feet Steel sign post North 0.55 feet

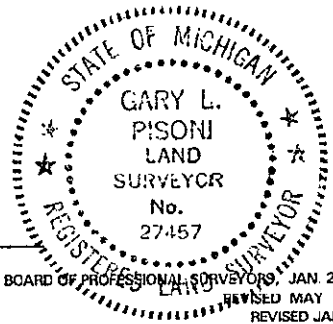

99-140 Signed by Gary L. Pisoni Date 12-28-99 Surveyor's Michigan License No. 27457

FORM APPROVED BY MICHIGAN STATE BOARD OF PROFESSIONAL SURVEYORS, JAN. 28, 1971 REVISED MAY 14, 1975 REVISED JAN., 1983 REVISED OCT., 1995