

FEB 22 1996

LAND CORNER RECORDATION CERTIFICATE
Filing Requirement of Act 74, Mich. P.A. 1970

For corners in

Iron (County)

Located In:

Corner Code #

1. Public Land Survey

T 42N R 35W

I-1

T 43N R 35W

I-13

T R

T R

2. Property Controlling in Section

S T R

S T R

3. Miscellaneous Property in Sec.

S T R

S T R

4. Lot No. , Recorded Plat

5. Private Claims

Section Corner 34, 35, 3, 2, T43N, R35W

I. Gary L. Pisoni in a field survey on October 21, 1994

do hereby certify that under requirements of P.A. 74, Michigan P.A. of 1970, the corner points mentioned in lines 1 and 2 above were in conformance with regulations and rules therefore as required in the current manual of survey instructions of the United States Department of the Interior, Bureau of Land Management or by a decree of a Court of Law and/or that the corner points mentioned in lines 3, 4 and 5 above were in conformance with the rules of the Michigan Board of Land Surveyors or by a Decree of a Court of Law; established, re-established, monumented, re-monumented, recovered, found as expressed below:

NOTE: Not more than 4 corners, all in the same town and range, may be recorded on this certificate.

A. Description of original monument and accessories and/or subsequent restoration:

Original corner established by John Burt, U.S. Deputy Surveyor in 1846.

Original corner: Sugar Post

Original bearing trees:

Sugar 14" N 75° E 30 links (19.80 feet)

Sugar 12" N 76° W 45 links (29.70 feet)

Original corner recovered by Harvey Mellen, U.S. Deputy Surveyor in 1851.

Original bearing trees:

Sugar 16" S 63° E 39 links (25.74 feet)

Sugar 14" S 66° W 26 links (17.16 feet)

B. Description of corner evidence found and/or method applied in restoring or reestablishing corner:

No evidence of original corner or bearing tree remains. Corner position found marked by an iron bar encased inside an 8" diameter iron pipe filled with concrete, located in the centerline of a North/South county road and the centerline of an East/West county road. Corner position has been used and accepted as the corner locally for many years. Set an aluminum pipe monument 6" below road bed surface as described below.

The corner is accepted as the best available evidence of the position of the corner.

County Record Research on file with County Representative Office.

C. Description of monument for corner and accessories established to perpetuate locating the position of the corner:

At the corner position, I set a 2" diameter by 30" long split base aluminum pipe monument with a 3" cast aluminum cap, stamped to read: Iron County Remonumentation, T43N, R35W, S-34, S-35, S-3, S-2, T42N, 1994, RLS- 27457 from which I established the following new blazed and scribed bearing trees: (all measurements taken to a nail in side of tree)

Sugar Maple 6" N 37° E 64.83 feet
Rebar 5/8" x 30" S 55° E 71.68 feet
Sugar Maple 14" S 48° W 44.99 feet
Utility Pole #3 N 44° W 35.44 feet
Steel Sign Post N 25° E 38.59 feet

Signed by Gary L. Pisoni

Date 1-9-95

Surveyor's Michigan License No. 27457

REGISTER'S OFFICE ) ..SS
IRON COUNTY, MICH. ) ..SS
RECEIVED FOR RECORD THE 21st DAY OF
FEBRUARY A.D. 19 95 AT
2:45 O'CLOCK P.M. AND RECORDED IN LIBER
6 OF L.C. RECORDS
ON PAGE 372
DEPUTY REGISTER OF DEEDS


Register of Deeds Stamp & File Number

Grid table with columns A-M and rows 2-13. Contains numbers 1-36 in a grid pattern.

PEER GROUP APPROVED

Iron Gary L. Pisoni
COUNTY REPRESENTATIVE

AP. 11-30-94

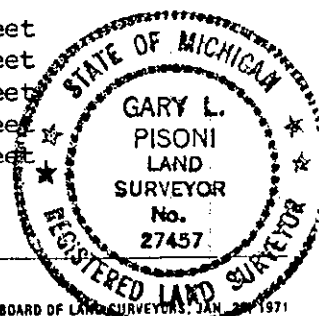

FORM APPROVED BY MICHIGAN STATE BOARD OF LAND SURVEYORS, JAN 27 1971
REVISED MAY 14, 1975
REVISED JAN., 1983

LIBER

6 PAGE 372