SURVEY & REMONUMENTATION COMMISSION
MAR 1 9 1997

LAND CORNER RECORDATION CERTIFICATE
Filing Requirement of Act 74, Mich. P.A. 1970

IRON COUNTY
MICHIGAN
RECEIVED FOR RECORD
96 APR 17 AM 8:28
L.C. Records L. 6, P. 433
Eileen Stelie
REGISTER OF DEEDS

For corners in IRON (County) located In: Corner Code #

1. Public Land Survey		T 42N R 35W	J - 3
		T___ R___	
		T___ R___	
		T___ R___	
2. Property Controlling	S___	T___ R___	
in Section	S___	T___ R___	
3. Miscellaneous	S___	T___ R___	
Property in Sec.	S___	T___ R___	

Register of Deeds Stamp & File Number

4. Lot No. _____ , Recorded Plat _____
5. Private Claims _____

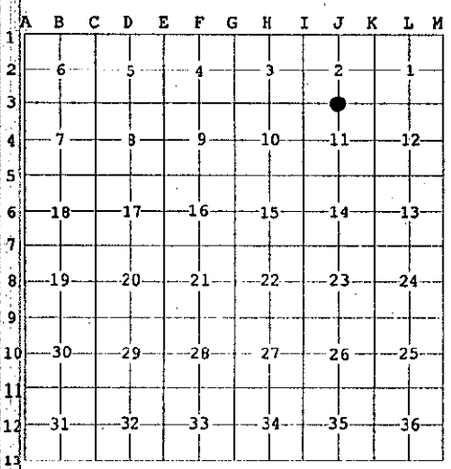

I, GERALD W. CARLSON, in a field survey on AUGUST 29TH, 19 95, do hereby state that under requirements of P.A. 74, Michigan P.A. of 1970, the corner points mentioned in lines 1 and 2 above were in conformance with regulations and rules therefore as required in the current manual of survey instructions of the United States Department of the Interior, Bureau of Land Management or by a decree of a Court of Law and/or that the corner points mentioned in lines 3, 4 and 5 above were in conformance with the rules of the Michigan Board of Land Surveyors or by a Decree of a Court of Law; established, re-established, monumented, recovered, found as expressed below:

NOTE: Not more than 2 corners, all in the same town and range, may be recorded on this certificate.

A. Description of original monument and accessories and/or subsequent restoration:

J-3: Quarter Corner common to Sections 2 and 11.
1851: Harvey Mellan's, D.S. subdivision notes describe the corner monument as a wood post referenced by:
4" Tamarack N73 1/2E, 24 links
6" Tamarack S76W, 54 links

Research on file with the Iron County Representative.

B. Description of corner evidence found and/or method applied in restoring or reestablishing corner:

No evidence of original corner or bearing trees found.

1995: A traverse was run from the the Southwest corner of Section 2 marked by a R.R. spike (this spike pointed out by Gary Pisoni, P.S.) located in a County road, opposite an old fence line running East, to the Southeast Corner of Section 2 marked by an Iron County Remonumentation aluminum pipe monument. A search for the South 1/4 corner was made with no evidence uncovered. The corner was set equidistant and on line between the Southwest and Southeast corners of Section 2. The line call leave swamp (47.00 chains coursing Southwest and Northeast) measured 30' short however the bearing of the swamp line is N46E making a conclusive measurement difficult. The distances East and West are 2629.29' and the distance North is 5252.25'. The calculated North-South line is 4.07' West of an old found iron in a North-South rock fence running South from the vicinity of the Center of Section.

PEER GROUP APPROVED
Iron Gary L. Pisoni 1-17-96
COUNTY REPRESENTATIVE

C. Description of monument for corner and accessories established to perpetuate locating the position of the corner:

1995: Set a 3 1/4" diameter aluminum tablet Iron County Remonumentation Monument stamped to identify the corner on a Berntsen rod consisting of three 4' long sections and 3/4" in diameter placed in swamp East of a pond and West of a creek and referenced by:
9' long Rail with bearing tree tag S00E, 6.0'
9' long Rail with bearing tree tag N45W 3.0'
Rails are 2 - 6' long sections overlapped and welded together for a 9' length.
The monument is 0.7' above the water surface.
No other accessories were available as the corner falls in a large swamp.
bk. 42-35-5, pg. 112
Job No. 94-277

STATE OF MICHIGAN
GERALD W. CARLSON
SURVEYOR
No. 24589
LICENSED PROFESSIONAL SURVEYOR

Signed by Gerald W Carlson Date 1-12-96

Surveyor's Michigan License No. 24589

FORM APPROVED BY MICHIGAN STATE BOARD OF PROFESSIONAL SURVEYORS, JAN. 28, 1971
REVISED MAY 14, 1975
REVISED JAN., 1983
REVISED OCT., 1995

L.6 P. 433