

FEB 22 1996

COMMISSION

LAND CORNER RECORDATION CERTIFICATE
Filing Requirement of Act 74, Mich. P.A. 1970

IRON COUNTY MICHIGAN
RECEIVED FOR RECORD

93 DEC 29 PH 2: 22
L.C. RECORDS L. 6 P. 30

Gilbert Stebbins
REGISTER OF DEEDS

For corners in

Iron
(County)

Located in:

Corner Code #

- 1. Public Land Survey T 43N R 35W
T 42N R 35W
T _____ R _____
T _____ R _____
- 2. Property Controlling in Section S _____ T _____ R _____
S _____ T _____ R _____
- 3. Miscellaneous Property in Sec. S _____ T _____ R _____
S _____ T _____ R _____

L-13
L-1

Register of Deeds Stamp & File Number

- 4. Lot No. _____, Recorded Plat _____
- 5. Private Claims _____

Quarter Corner 36-1 T43-42N R35W

Gary L. Pisoni, in a field survey on December 21, 1993

do hereby certify that under requirements of P.A. 74, Michigan P.A. of 1970, the corner points mentioned in lines 1 and 2 above were in conformance with regulations and rules therefore as required in the current manual of survey instructions of the United States Department of the Interior, Bureau of Land Management or by a decree of a Court of Law and/or that the corner points mentioned in lines 3, 4 and 5 above were in conformance with the rules of the Michigan Board of Land Surveyors or by a Decree of a Court of Law; established, re-established, monumented, re-monumented, recovered, found as expressed below:

NOTE: Not more than 4 corners, all in the same town and range, may be recorded on this certificate.

	A	B	C	D	E	F	G	H	I	J	K	L	M
2	6		5		4		3		2		1		
3													
4	7		8		9		10		11		12		
5													
6	18		17		16		15		14		13		
7													
8	19		20		21		22		23		24		
9													
10	30		29		28		27		26		25		
11													
12	31		32		33		34		35		36		
13													

A. Description of original monument and accessories and/or subsequent restoration:

Original corner established by John Burt, U.S. Deputy Surveyor on September 10, 1846.

Original corner: Sugar Post

Original bearing trees:

Elm	20"	N 48° E	11 links (7.26 feet)
Elm	20"	N 66° W	41 links (27.06 feet)

B. Description of corner evidence found and/or method applied in restoring or reestablishing corner:


No evidence of original corner or bearing tree remains. Corner position found marked by a drill rod with a punch mark inside of monument box. Corner located in centerline of 19th Street and on the West side of Lincoln Street. Quarter corner is part of the Assessor's Plat of Dober dating back to the 1930's.

This corner is accepted as the best available evidence of the position of the original corner.

C. Description of monument for corner and accessories established to perpetuate locating the position of the corner:

From the above corner monument, I established the following new corner references:
(all measurements taken to reference object or to a nail in side of Utility Pole)

Utility Pole	#18	N 54° E	40.39 feet
Telephone Pole	1900MBT	S 13° W	53.79 feet
Top Fire Hydrant		N 50° W	43.08 feet
Rebar	5/8"x30"	N 60° E	47.45 feet
Rebar	5/8"x30"	S 40° W	47.44 feet

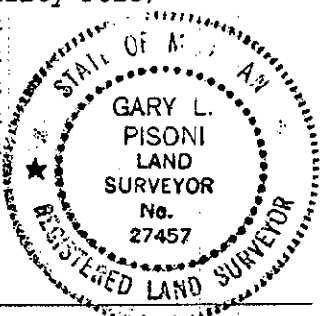

Signed by *Gary L. Pisoni*

Date 12-28-93

Surveyor's Michigan License No. 27457