

**SURVEY & REMONUMENTATION**

JAN 19 1999

**SECTION**

**LAND CORNER RECORDATION CERTIFICATE**  
Filing Requirement of Act 74, Mich. P.A. 1970

For corners in

| Iron<br>(County)                   | Located In:               | Corner Code # |
|------------------------------------|---------------------------|---------------|
| 1. Public Land Survey              | T <u>42N</u> R <u>34W</u> | <u>A-1</u>    |
|                                    | T <u>42N</u> R <u>35W</u> | <u>M-1</u> ✓  |
|                                    | T <u>43N</u> R <u>34W</u> | <u>A-13</u>   |
|                                    | T <u>43N</u> R <u>35W</u> | <u>M-13</u>   |
| 2. Property Controlling in Section | S _____ T _____ R _____   | _____         |
|                                    | S _____ T _____ R _____   | _____         |
| 3. Miscellaneous Property in Sec.  | S _____ T _____ R _____   | _____         |
|                                    | S _____ T _____ R _____   | _____         |

IRON COUNTY  
MICHIGAN  
RECEIVED FOR RECORD

98 DEC 28 AM 11:30  
L.C. Records: L. 7, P. 339  
*Richard Stedman*

Register of Deeds Stamp & File Number

4. Lot No. \_\_\_\_\_, Recorded Plat \_\_\_\_\_  
5. Private Claims \_\_\_\_\_

Section Corner Section 36, T43N, R35W; Section Corner Section 31, T43N, R34W  
Section Corner Section 1, T42N, R35W; Section Corner Section 6, T42N, R34W

I, Gary L. Pisoni, in a field survey on Dec. 16, 1998 do hereby state that under requirements of P.A. 74, Michigan P.A. of 1970, the corner points mentioned in lines 1 and 2 above were in conformance with regulations and rules therefore as required in the current manual of survey instructions of the United States Department of the Interior, Bureau of Land Management or by a decree of a Court of Law and /or that the corner points mentioned in lines 3, 4 and 5 above were in conformance with the rules of the Michigan Board of Land Surveyors or by a Decree of a Court of Law; established, re-established, monumented, recovered, found as expressed below:

|    |   |    |   |    |   |    |   |    |   |    |   |    |   |
|----|---|----|---|----|---|----|---|----|---|----|---|----|---|
| 1  | A | B  | C | D  | E | F  | G | H  | I | J  | K | L  | M |
| 2  |   | 6  |   | 5  |   | 4  |   | 3  |   | 2  |   | 1  |   |
| 3  |   |    |   |    |   |    |   |    |   |    |   |    |   |
| 4  |   | 7  |   | 8  |   | 9  |   | 10 |   | 11 |   | 12 |   |
| 5  |   |    |   |    |   |    |   |    |   |    |   |    |   |
| 6  |   | 18 |   | 17 |   | 16 |   | 15 |   | 14 |   | 13 |   |
| 7  |   |    |   |    |   |    |   |    |   |    |   |    |   |
| 8  |   | 19 |   | 20 |   | 21 |   | 22 |   | 23 |   | 24 |   |
| 9  |   |    |   |    |   |    |   |    |   |    |   |    |   |
| 10 |   | 30 |   | 29 |   | 28 |   | 27 |   | 26 |   | 25 |   |
| 11 |   |    |   |    |   |    |   |    |   |    |   |    |   |
| 12 |   | 31 |   | 32 |   | 33 |   | 34 |   | 35 |   | 36 |   |

NOTE: Not more than 2 corners, all in the same town and range, may be recorded on this certificate.

A. Description of original monument and accessories and/or subsequent restoration:

PEER GROUP APPROVED  
Iron Co. Rep. 12-18-98  
COUNTY REPRESENTATIVE

Original corner established in 1846, by William A. Burt, U.S. Deputy Surveyor.  
Original Corner; Cedar Post  
Original Bearing Trees:  
Yellow Birch 12" N 42 1/2° E 29 links (19.14 feet)  
Cedar 12" S 74° W 11 links (7.26feet)

B. Description of corner evidence found and/or method applied in restoring or reestablishing corner:

No evidence of original B.T.s found. Found a 1" diameter iron bar encased in concrete marking corner position and located in the centerline of a county road to the East and the centerline line of Baker Road to the South. Corner position was set by the local mining company in the 1950's. I accept the iron bar in concrete as the best available evidence for restoring the corner position.

Corner record research on file with County Representative.

C. Description of monument for corner and accessories established to perpetuate locating the position of the corner:

From the above described corner position, I set a reference monument, being a 5/8" diameter by 30" long rebar, with a 3" diameter aluminum cap stamped as follows:  
Iron County Remonumentation, T43N, R35W, R34W, R.M., S-36, S-31, S-1, S-6, South, 2.77', T42N, 1998, RLS 27457, from which I blazed and scribed the following new bearing trees: (All measurements taken to a nail in side of tree)

|                 |                  |        |            |
|-----------------|------------------|--------|------------|
| Popple          | 6"               | S 20°W | 36.94 feet |
| Popple          | 7"               | S 85°W | 10.31 feet |
| R.M.            | 5/8" x 30" rebar | North  | 2.77 feet  |
| Steel sign post |                  | North  | 3.37 feet  |


98-167

Signed by Gary L. Pisoni

Date 12-21-98

Surveyor's Michigan License No. 27457

FORM APPROVED BY MICHIGAN STATE BOARD OF PROFESSIONAL SURVEYORS, JAN. 28, 1971  
No. 27457  
REVISOR MAY 14, 1975  
REVISOR JAN. 1983  
REVISOR OCT., 1995

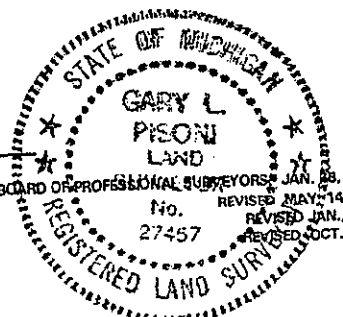

L. 7 P. 339