

REMONUMENTATION

FEB 22 1996

COMMISSION

For corners in

LAND CORNER RECORDATION CERTIFICATE
Filing Requirement of Act 74, Mich. P.A. 1970

IRON COUNTY
MICHIGAN
RECEIVED FOR RECORD

93 DEC 29 PM 2: 22

L.L. RECORDS L.C. P. 304

Eileen Stobie
REGISTER OF DEEDS

| | | |
|---------------------------------------|-------------------------|---------------|
| Iron (County) | Located In: | Corner Code # |
| 1. Public Land Survey | T 42N R 35W | M-3 |
| | T 42N R 34W | A-3 |
| | T _____ R _____ | _____ |
| | T _____ R _____ | _____ |
| 2. Property Controlling in Section | S _____ T _____ R _____ | _____ |
| | S _____ T _____ R _____ | _____ |
| 3. Miscellaneous Property in Sec. | S _____ T _____ R _____ | _____ |
| | S _____ T _____ R _____ | _____ |
| 4. Lot No. _____, Recorded Plat _____ | | |
| 5. Private Claims _____ | | |

Register of Deeds Stamp & File Number

Section Corner 1-6-12-7 T42N R35-34W

Gary L. Pisoni, in a field survey on December 21, 1993 do hereby certify that under requirements of P.A. 74, Michigan P.A. of 1970, the corner points mentioned in lines 1 and 2 above were in conformance with regulations and rules therefore as required in the current manual of survey instructions of the United States Department of the Interior, Bureau of Land Management or by a decree of a Court of Law and/or that the corner points mentioned in lines 3, 4 and 5 above were in conformance with the rules of the Michigan Board of Land Surveyors or by a Decree of a Court of Law: established, re-established, monumented, re-monumented, recovered, found as expressed below:

| A | B | C | D | E | F | G | H | I | J | K | L | M |
|----|----|----|----|----|----|----|---|---|---|---|---|---|
| 2 | 6 | 5 | 4 | 3 | 2 | 1 | | | | | | |
| 3 | | | | | | | | | | | | |
| 4 | 7 | 8 | 9 | 10 | 11 | 12 | | | | | | |
| 5 | | | | | | | | | | | | |
| 6 | 16 | 17 | 16 | 15 | 14 | 13 | | | | | | |
| 7 | | | | | | | | | | | | |
| 8 | 19 | 20 | 21 | 22 | 23 | 24 | | | | | | |
| 9 | | | | | | | | | | | | |
| 10 | 30 | 29 | 28 | 27 | 26 | 25 | | | | | | |
| 11 | | | | | | | | | | | | |
| 12 | 31 | 32 | 33 | 34 | 35 | 36 | | | | | | |
| 13 | | | | | | | | | | | | |

NOTE: Not more than 4 corners, all in the same town and range, may be recorded on this certificate.

A. Description of original monument and accessories and/or subsequent restoration:

Original corner established by William A. Burt, U.S. Deputy Surveyor in 1846.

Original corner: Wood Post

Original bearing trees:

| | | | |
|--------|-----|---------|-----------------------|
| Fir | 14" | N 85° E | 13 links (8.58 feet) |
| Spruce | 14" | S 68° W | 19 links (12.54 feet) |
| Cedar | 12" | S 50° E | 45 links (29.70 feet) |
| Spruce | 10" | N 35° W | 35 links (23.10 feet) |

3. Description of corner evidence found and/or method applied in restoring or reestablishing corner:


No evidence of original corner or bearing tree remains. Corner position found marked by a 3/4" iron pin in monument box. Corner located in centerline of County Road 424 and the East side of an old road running South.

This corner is accepted as the best available evidence of the position of the original corner.

2. Description of monument for corner and accessories established to perpetuate locating the position of the corner:

From the above corner monument, I established the following new corner references: (all measurements taken to a nail in side of tree, or to a reference object)

| | | | |
|-----------------|----------|---------|-------------|
| Rebar | 5/8"x30" | N 59° E | 30.69 feet |
| Aspen | 5" | S 40° E | 34.21 feet |
| Aspen | 10" | S 42° W | 120.98 feet |
| Rebar | 5/8"x30" | N 70° W | 30.00 feet |
| Steel Sign Post | | North | 10.27 feet |

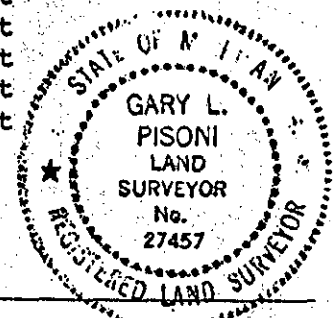

Signed by *Gary L. Pisoni*

Date 12-28-93

Surveyor's Michigan License No. 27457